





GROSS AREAS:
 MAIN LEVEL: 9,416 SF
 LOWER LEVEL: 3,816 SF
 TOTAL: 13,232 SF

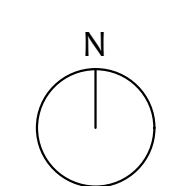

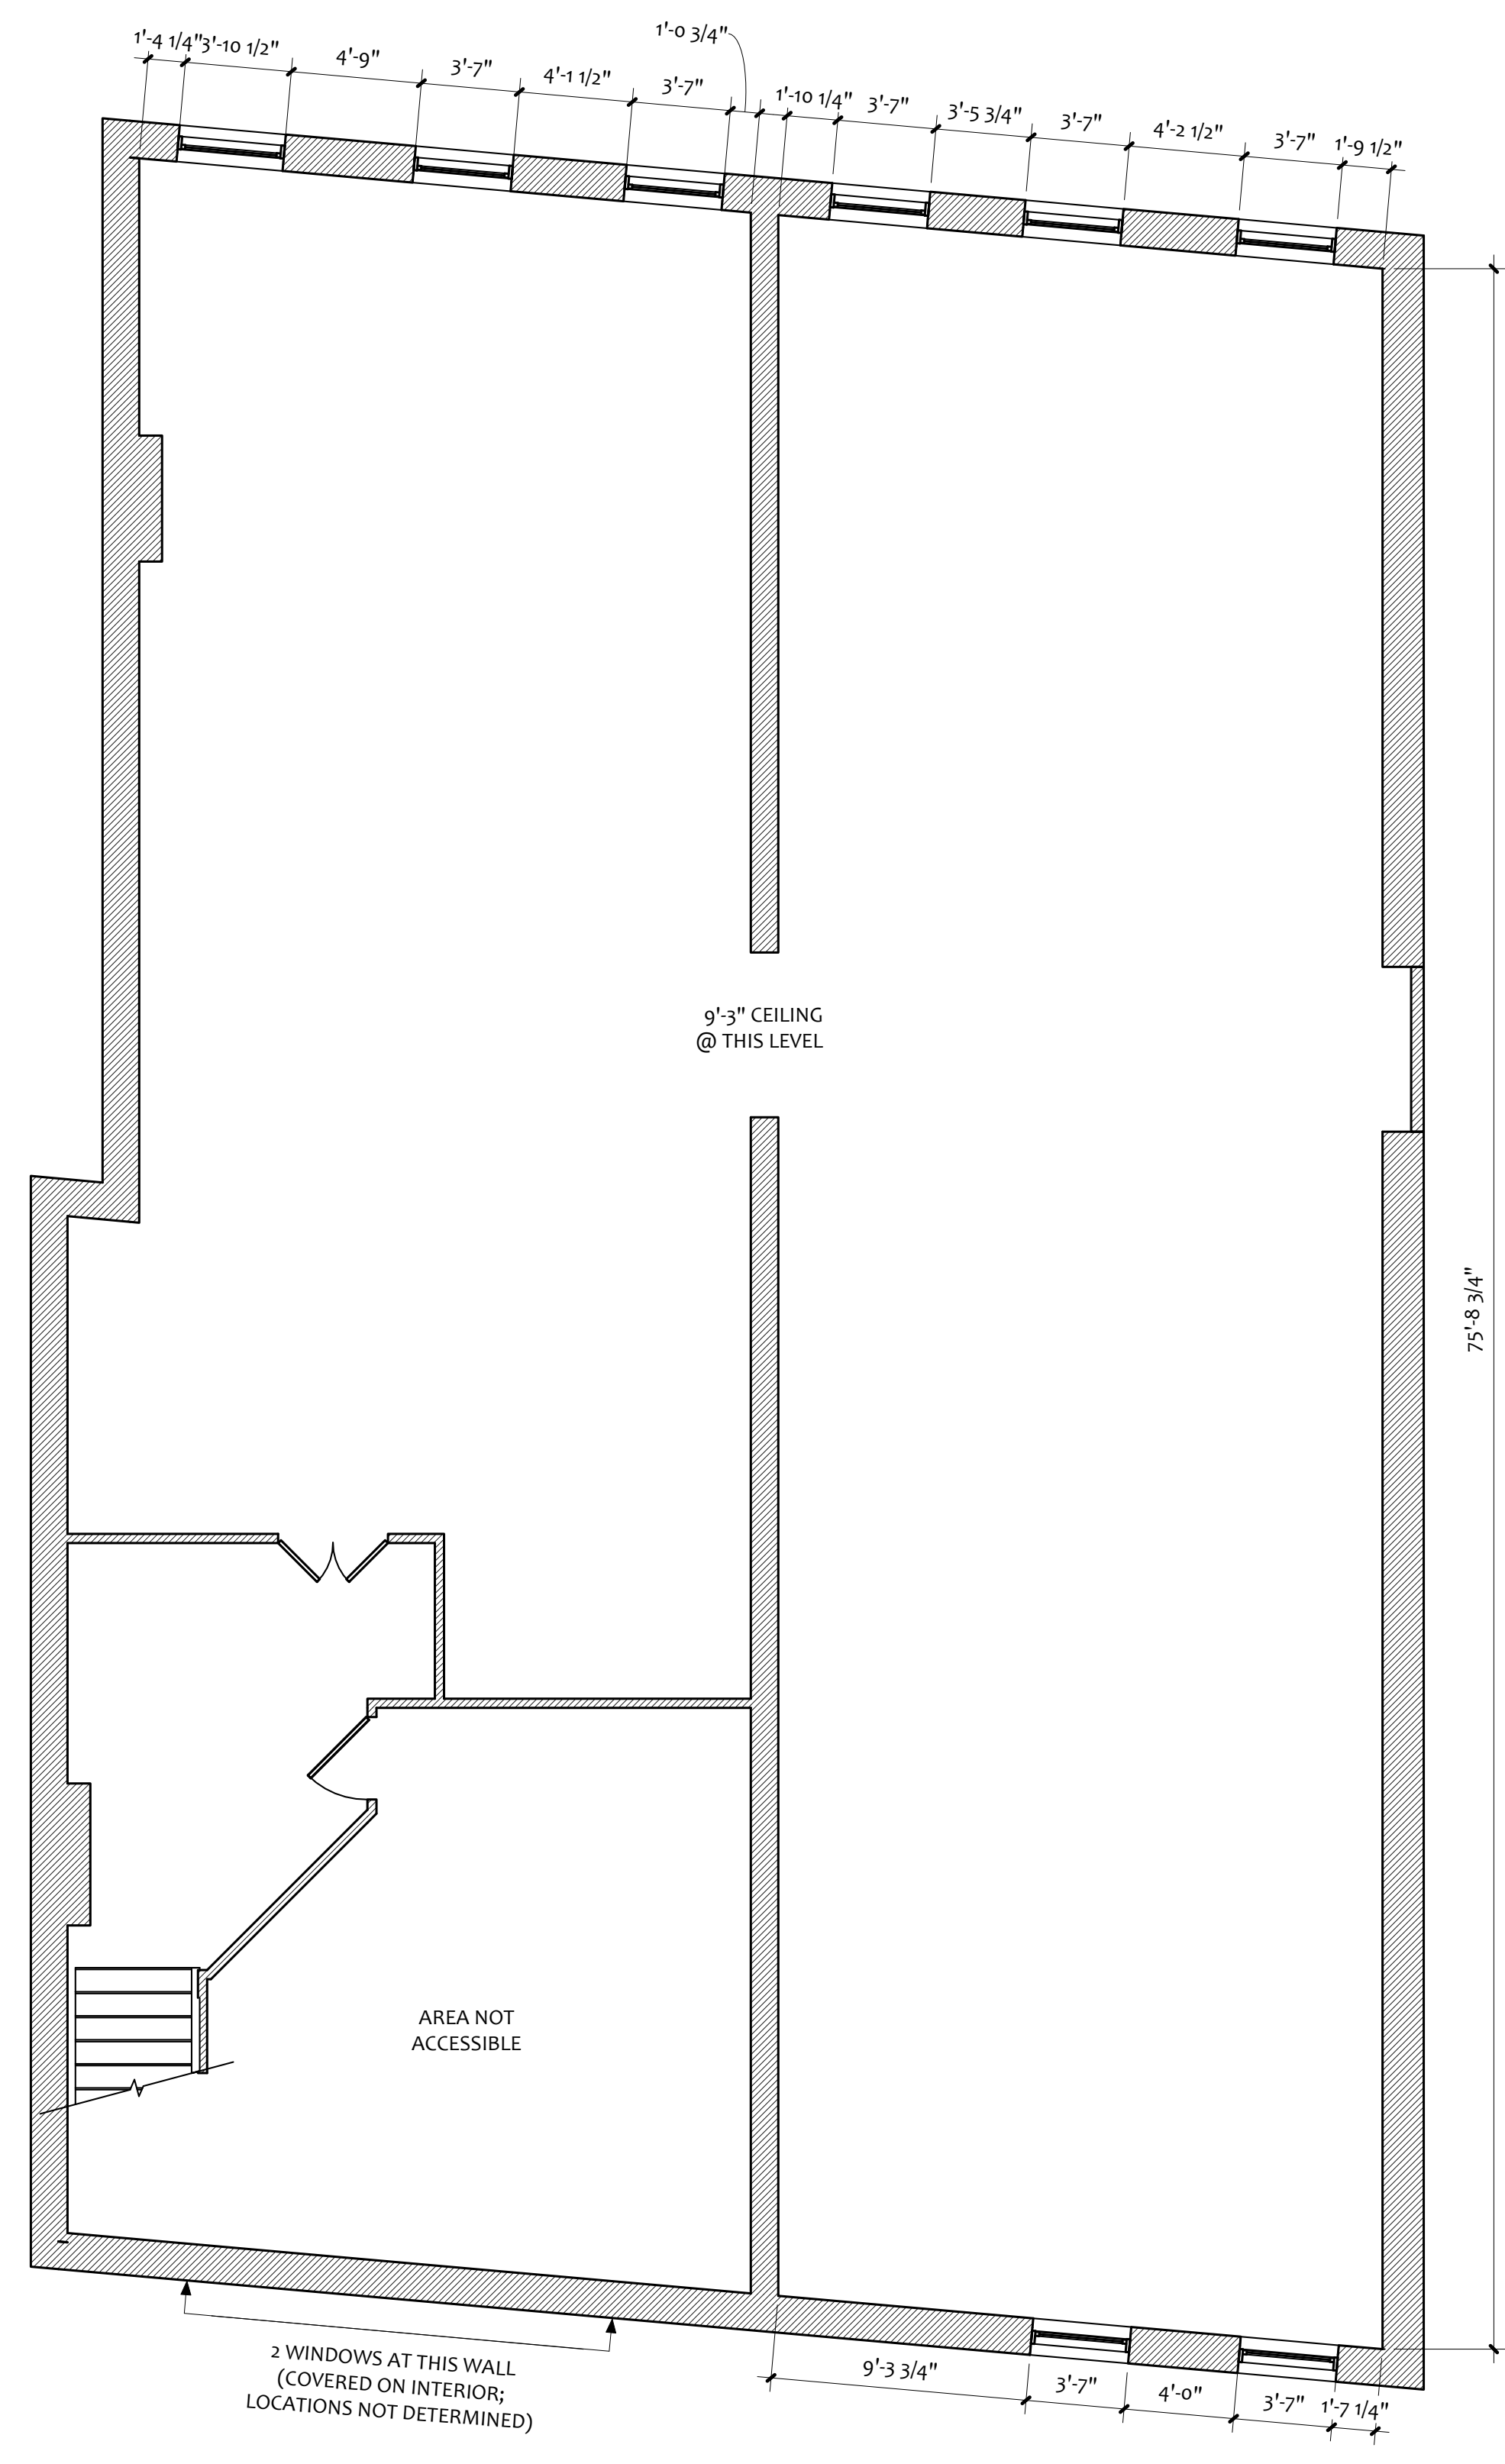

GROSS AREAS:
 MAIN LEVEL: 9,416 SF
 LOWER LEVEL: 3,816 SF
 TOTAL: 13,232 SF

