


"AS BUILT" DRAWING
MEASURED BY MR LLC



TESSIER
PROPERTY BROKERAGE & MANAGEMENT

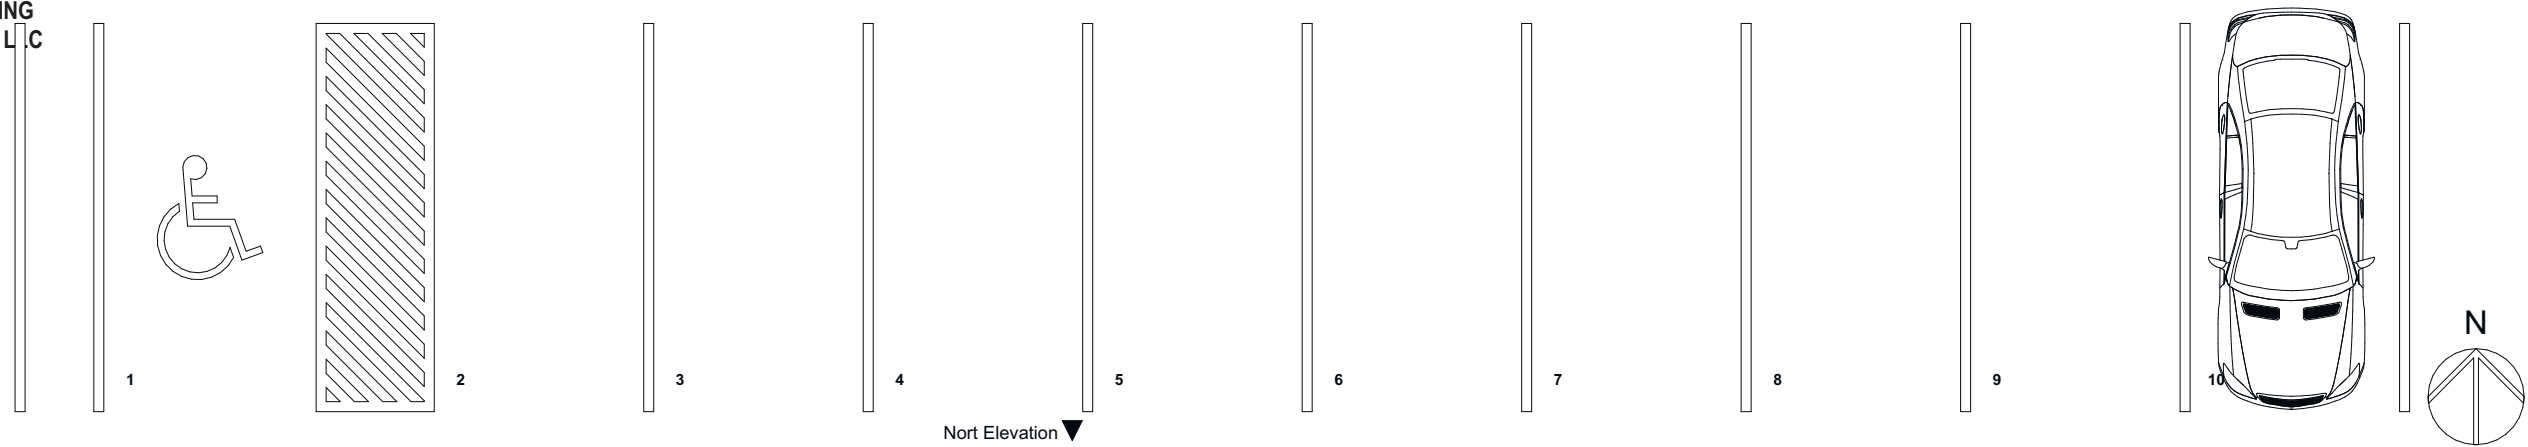

GENERAL NOTES:
1. DO NOT USE AS A BLUEPRINTS WITHOUT MR LLC PERMISSION.
2. PLEASE NOTE INTERIOR DIMENSIONS WERE NOT USED IN CALCULATING SQUARE FOOTAGE.
3. SIZE OF HEATED AND NOT HEATED AREA AND OTHER INFORMATION WERE OBTAINED PER THE NC REAL ESTATE COMMISSION GUIDELINES (6" FOR EXTERNAL WALLS EXCEPT CONDOMINIUMS)
4. FOR REMODELING QUESTIONS OR MORE DETAILED CAD DRAWINGS (INC. SITE PLAN, SECTIONS, ELEVATIONS) ALSO 3D MODEL PLEASE CONTACT ALFRED ZALYS MOB. 828 231 7305 E-MAIL: A.ZALYS@HOTMAIL.COM


LEGEND:
1. FITNESS CENTER



LEGEND MAP:
FINISHED COMMERCIAL
NOT HEATED/NOT FINISHED
WOOD/CER.TILES
CONCRETE/ASPHALT

Revision History

RevID	Chd	Change Name	Date

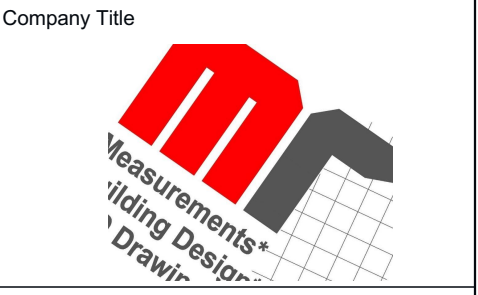

Company
MEASURE RITE LLC
23 Clement Place, Asheville
Buncombe County NC 28805

Site Address
**204 S King Street
Hendersonville, NC 28792**

Drawing Name
**Main Level , Generic
Perspective (1), Generic
Perspective (2), Site Plan (1)**

Drawing Status
AS BUILT

Drawing Scale
1/8" = 1'-0", 1/16" = 1'-0", 1" = 100'

Contact Name
Alfred ZALYS
mob. 828 231 7305
e-mail: a.zalys@hotmail.com

Layout Nr.
1
Layouts Total
1
Paper Size
ANSI B
Date
6/14/2021

Job Nr.
MR 732
Layout ID
A001

Revision



**UNIT: 204 S King Street Hendersonville
MAIN FLOOR
(COMMERCIAL FLOOR A.) = 5,985.00 SQ.FT.**

D:\MR Design-2016-2021\732 204 S King Street Hendersonville, NC 28792\204 S King Street Hendersonville, NC 28792.pln

