



ALL SITE CONDITIONS AND DIMENSIONS MUST BE FIELD VERIFIED BEFORE BEGINNING WORK.

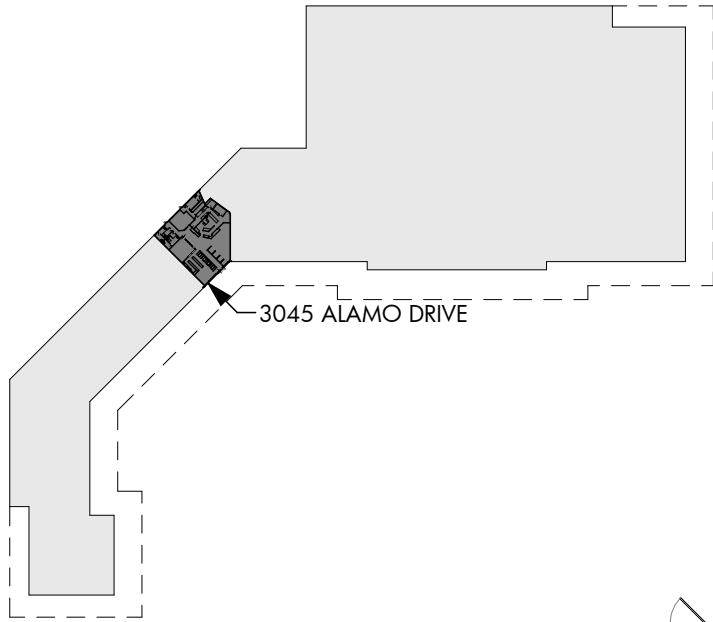

**OVERALL BUILDING PLAN**

NOT TO SCALE

BLACK ARROW: TRUE NORTH  
GRAY ARROW: PROJECT NORTH

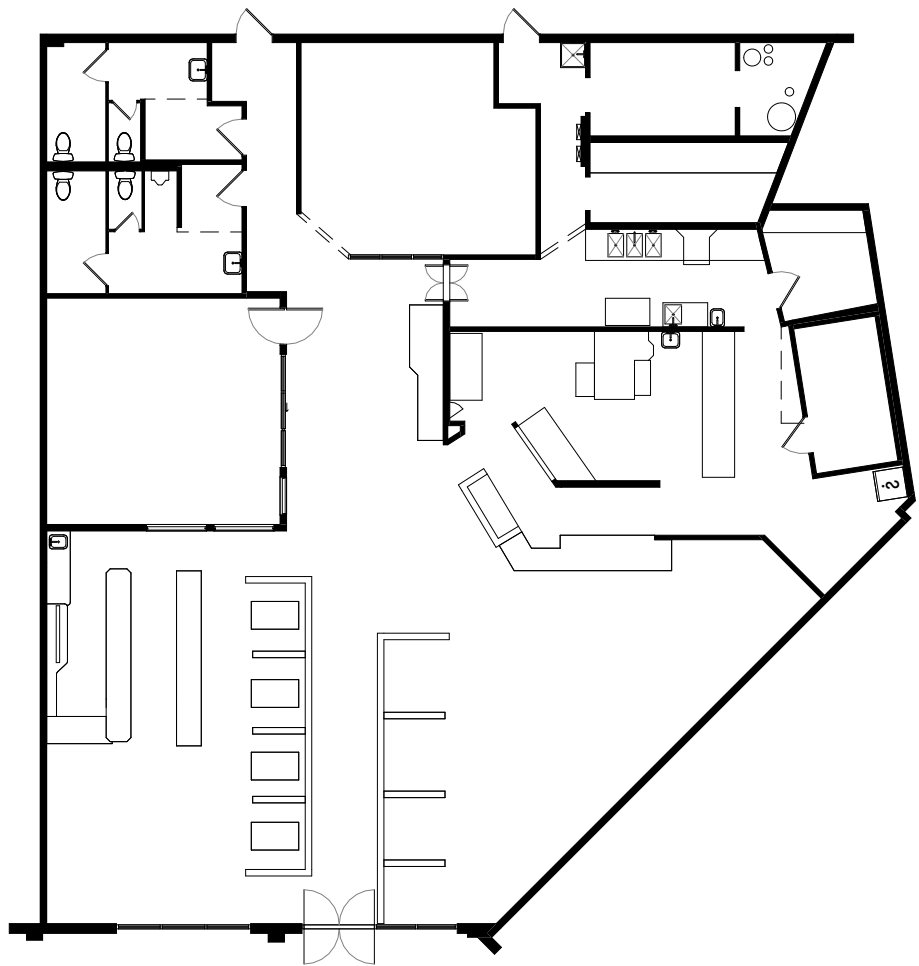

3045 AS-BUILT PLAN

4614 GSF


1/16" = 1'-0"

1

AS-BUILT FOR:

3045 Alamo Drive, Vacaville, CA 95687

ALL SITE CONDITIONS AND DIMENSIONS MUST BE FIELD VERIFIED BEFORE BEGINNING WORK.

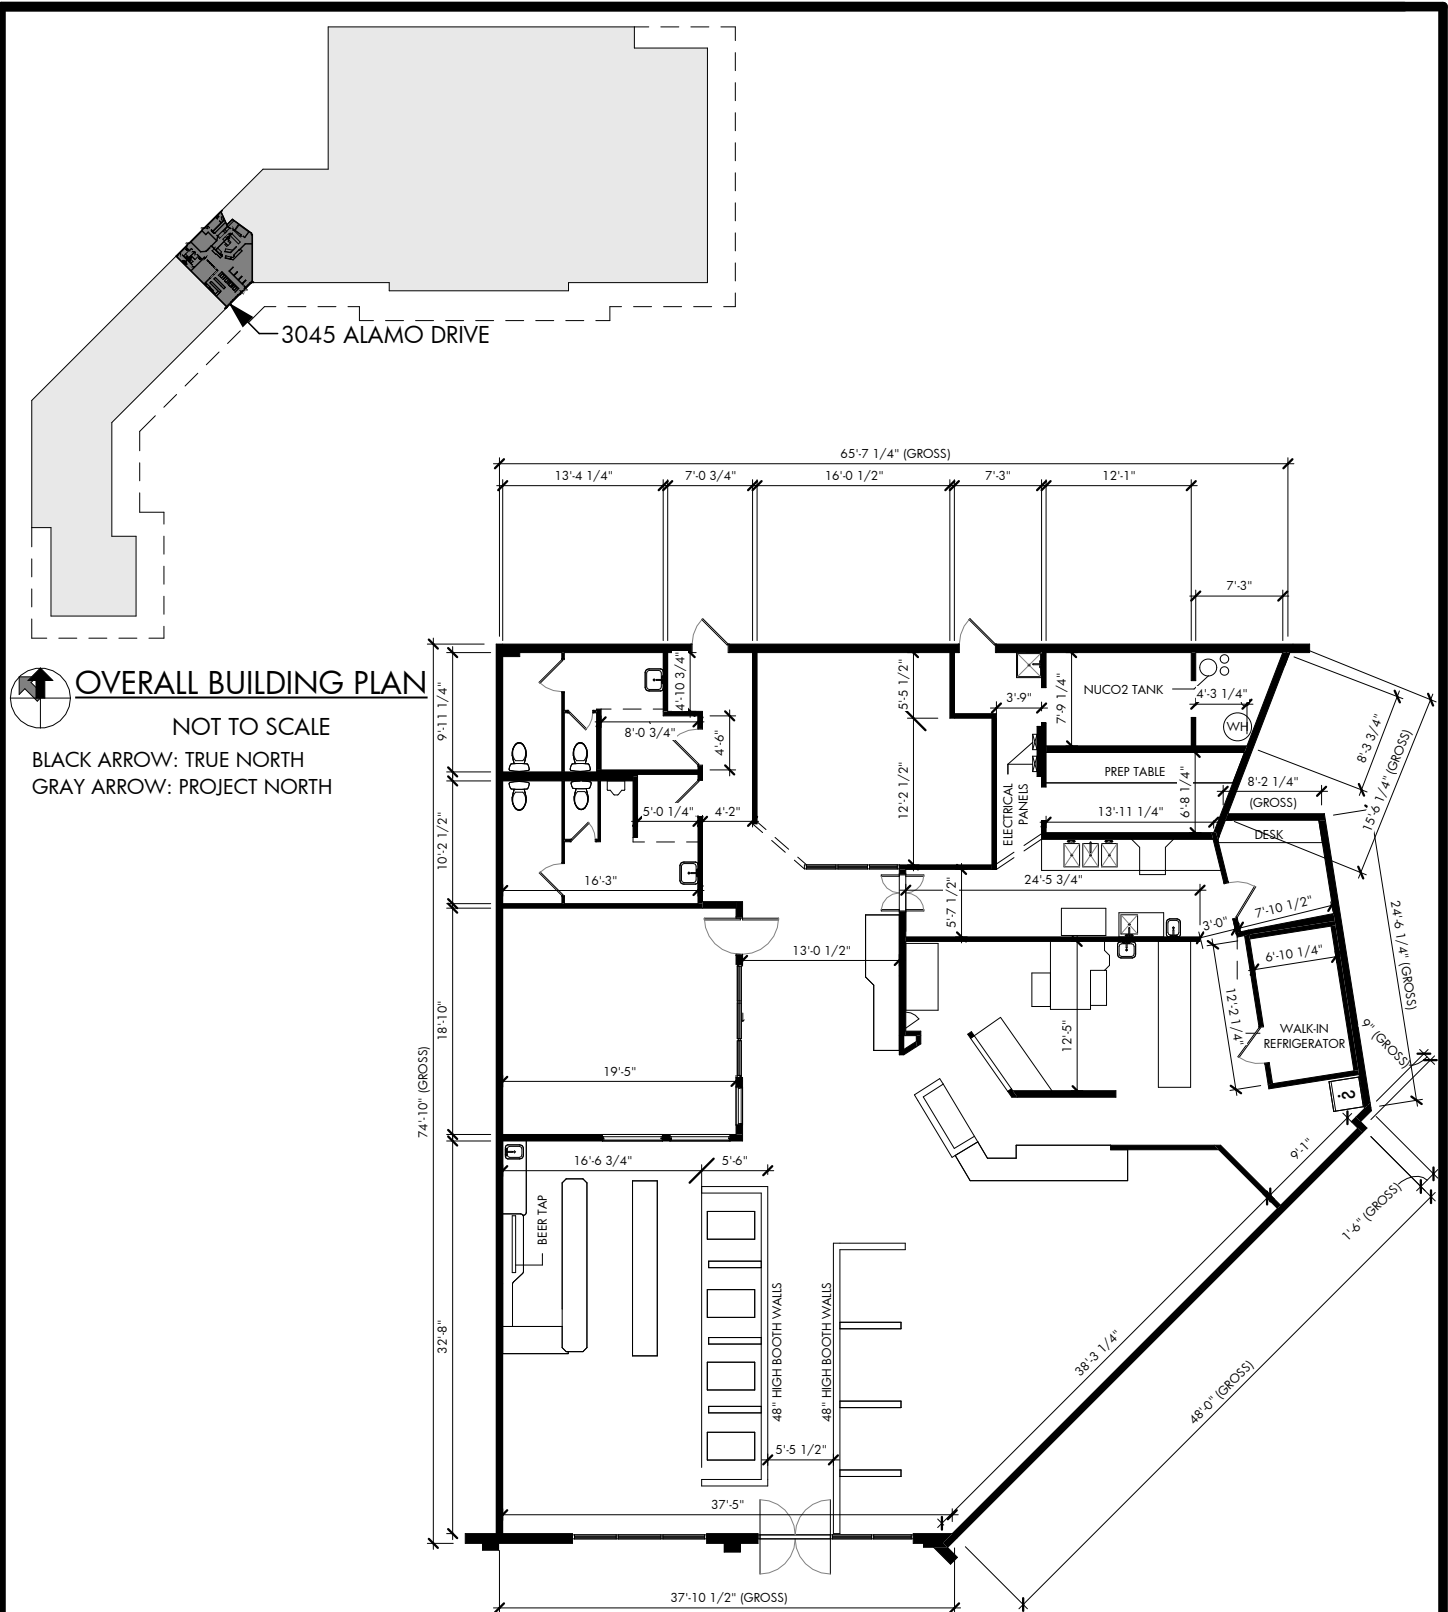

**OVERALL BUILDING PLAN**  
 NOT TO SCALE  
 BLACK ARROW: TRUE NORTH  
 GRAY ARROW: PROJECT NORTH

**3045 AS-BUILT PLAN W/ DIMENSIONS**

4614 GSF

1/16" = 1'-0"

1

AS-BUILT FOR:  
 3045 Alamo Drive, Vacaville, CA 95687