



SMITH POWER SYSTEMS, INC.

34,500 SF AS BUILT FLOOR PLAN FOR MARKETING

3233 IRVING BLVD. AND 5015 SHARP STREET DALLAS, TEXAS 75247

Copyright © 2024
Space Planning Specialists
These drawings, or parts thereof, may not be reproduced in any form, by any method, for any purpose, without prior written consent from Space Planning Specialists

SPACE PLANNING SPECIALISTS
COMMERCIAL SPACE PLANNING & INTERIOR DESIGN
(972) 414-9391
SpacePlanningSpecialists.com


SCALE: GRAPHIC SCALE
on 11"x8.5" plot

ISSUE DATES:
07/31/2024 AS BUILT PLAN
08/09/2024 GRAPHIC SITE PLAN

SHEET A5 OF 05 SHEET(S)



08/09/2024

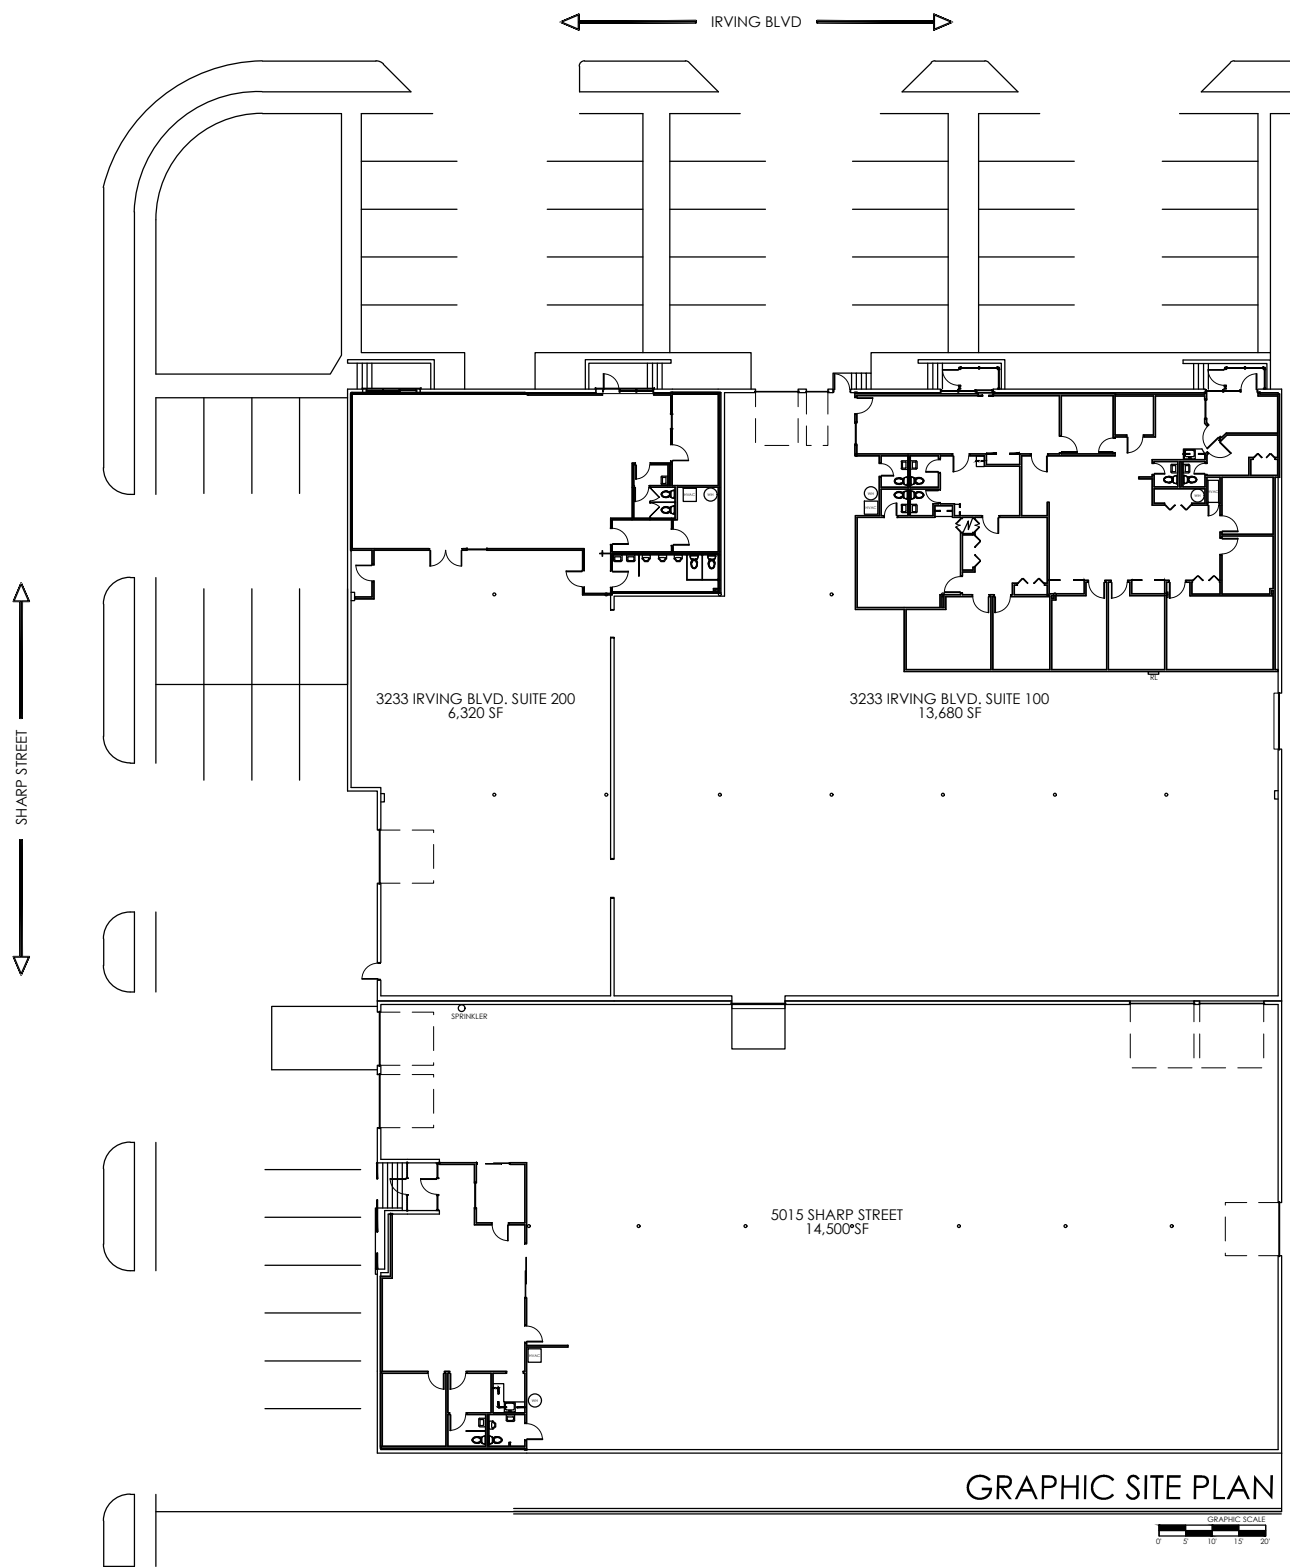

GRAPHIC SITE PLAN

