

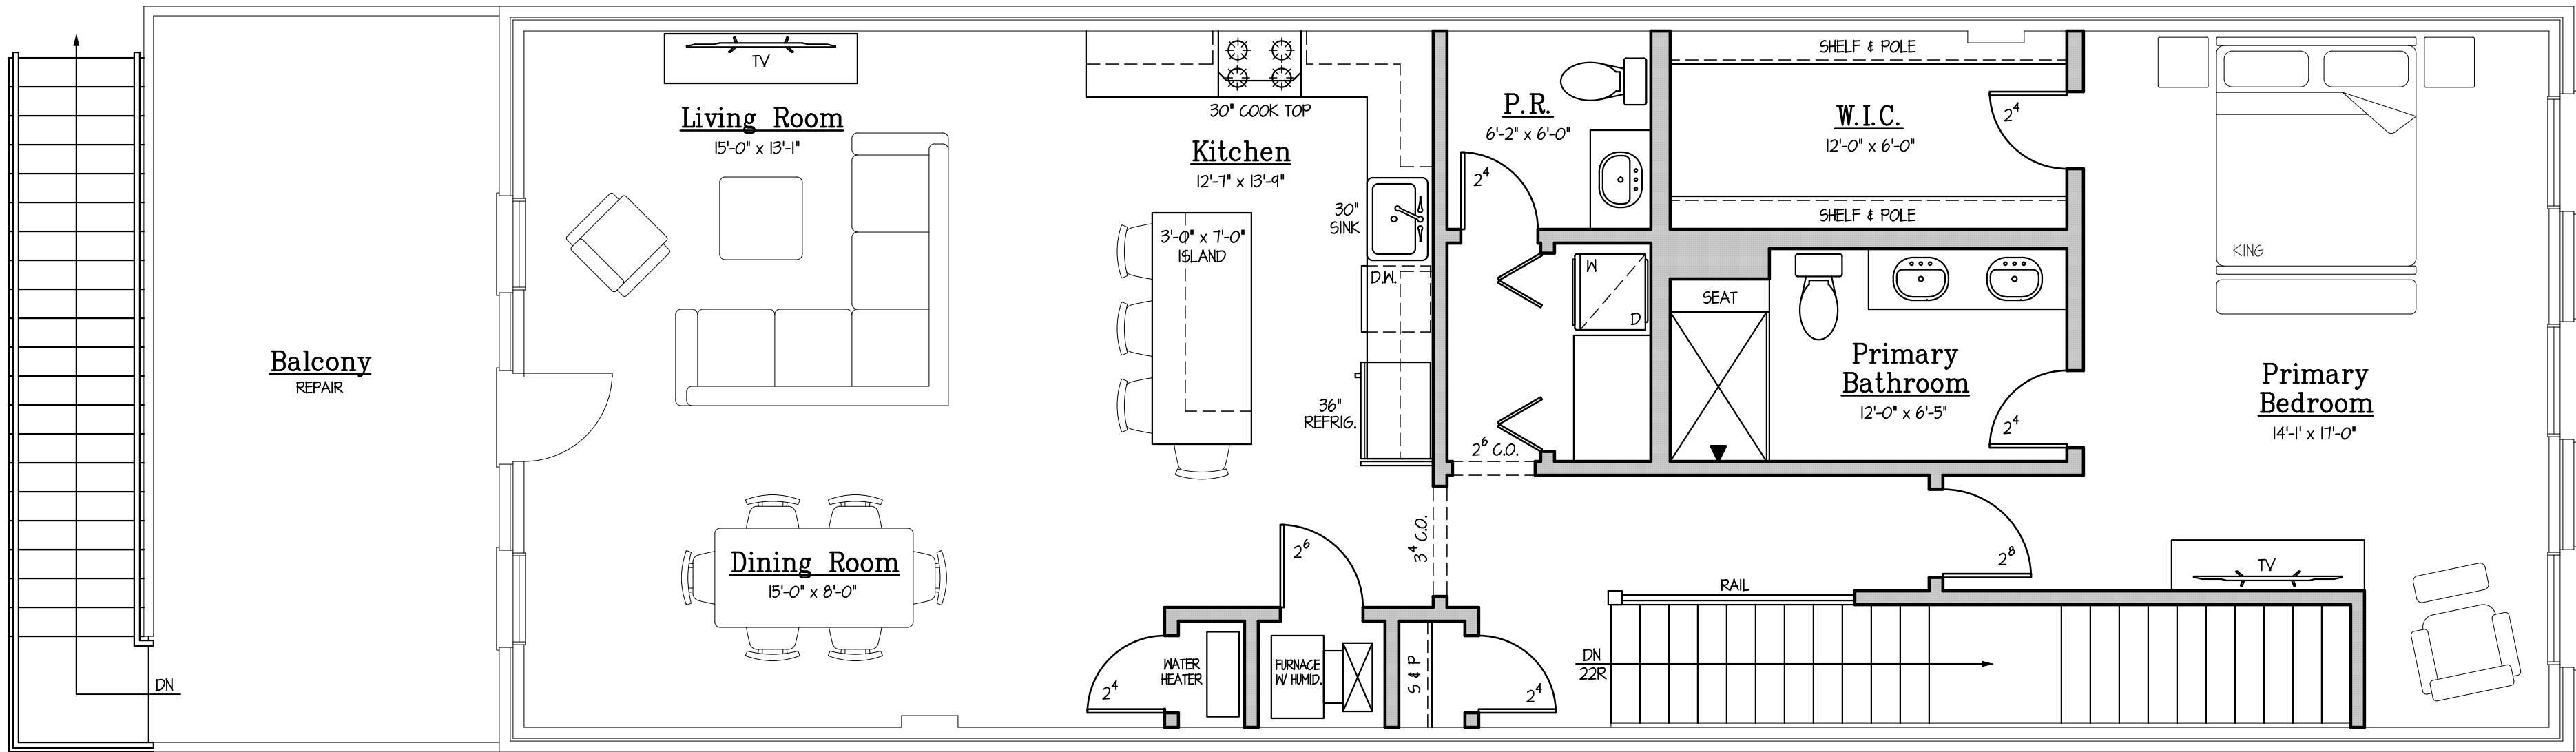


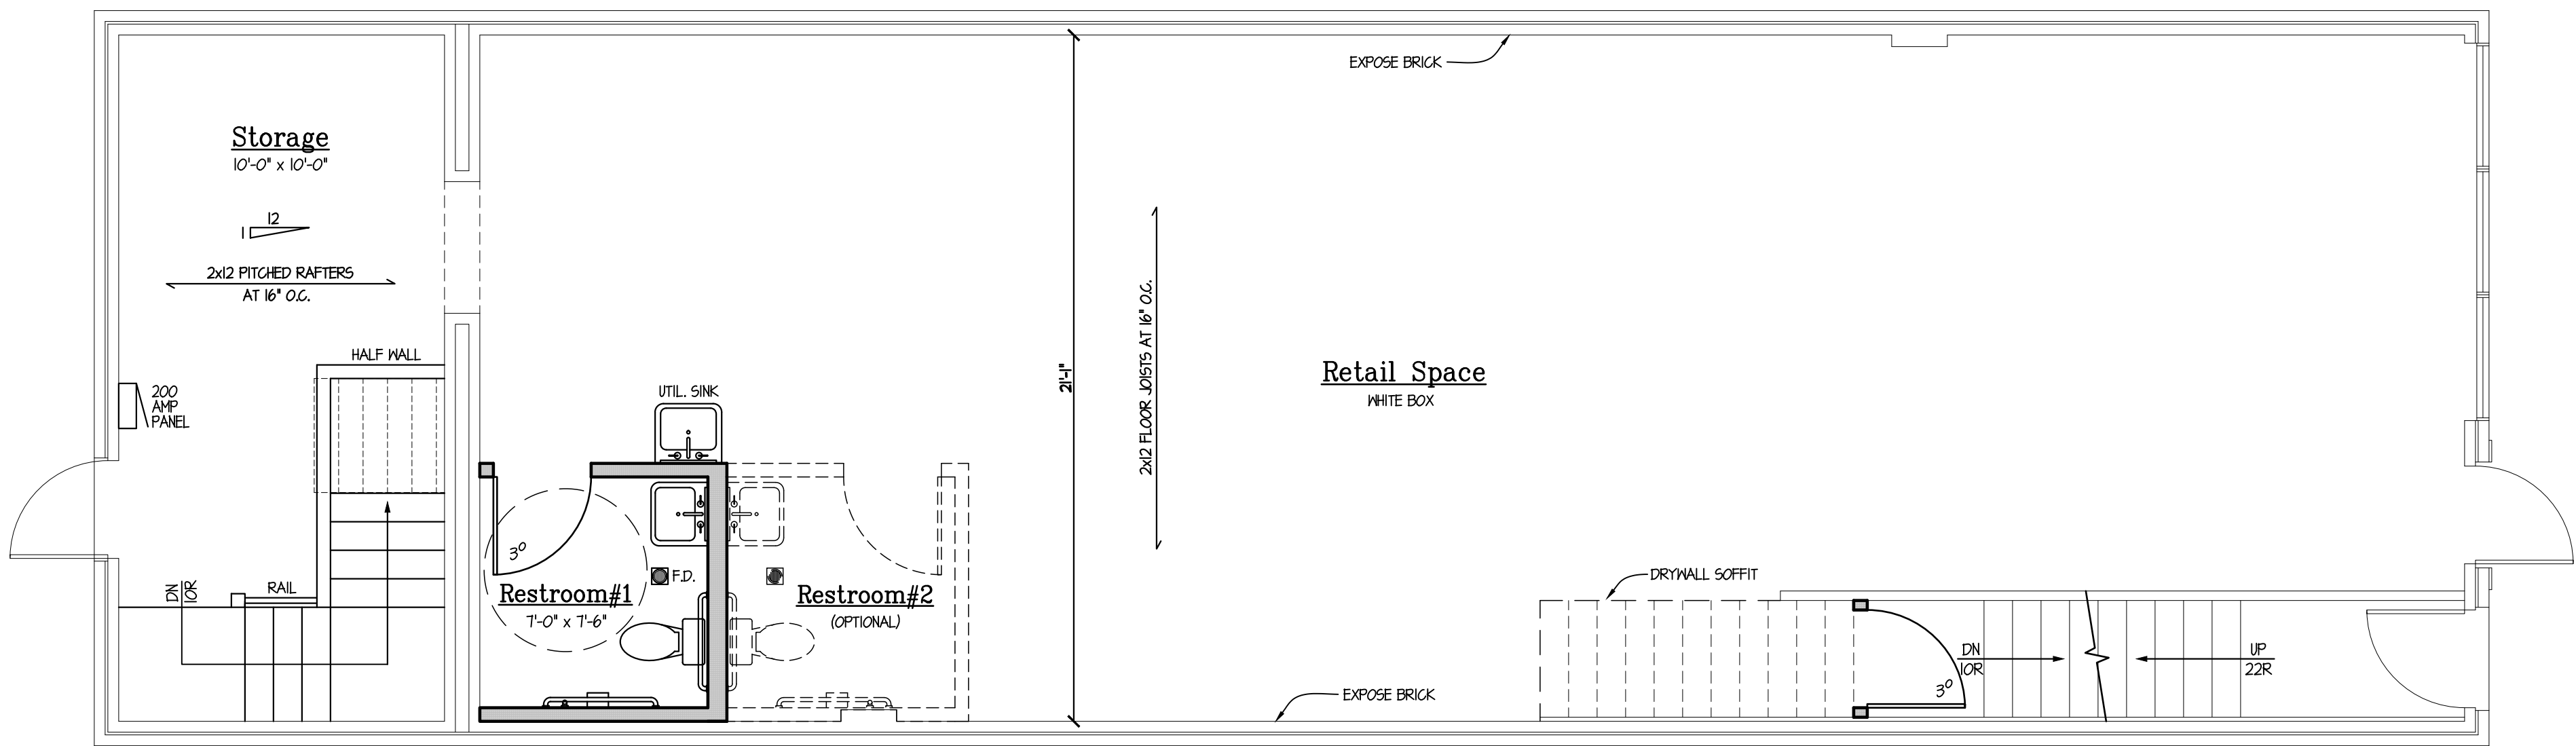

Proposed Second Floor Plan



OPTION: A

Scale: 1/4"=1'-0"

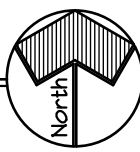



Proposed First Floor Plan

Scale: 1/4"=1'-0"

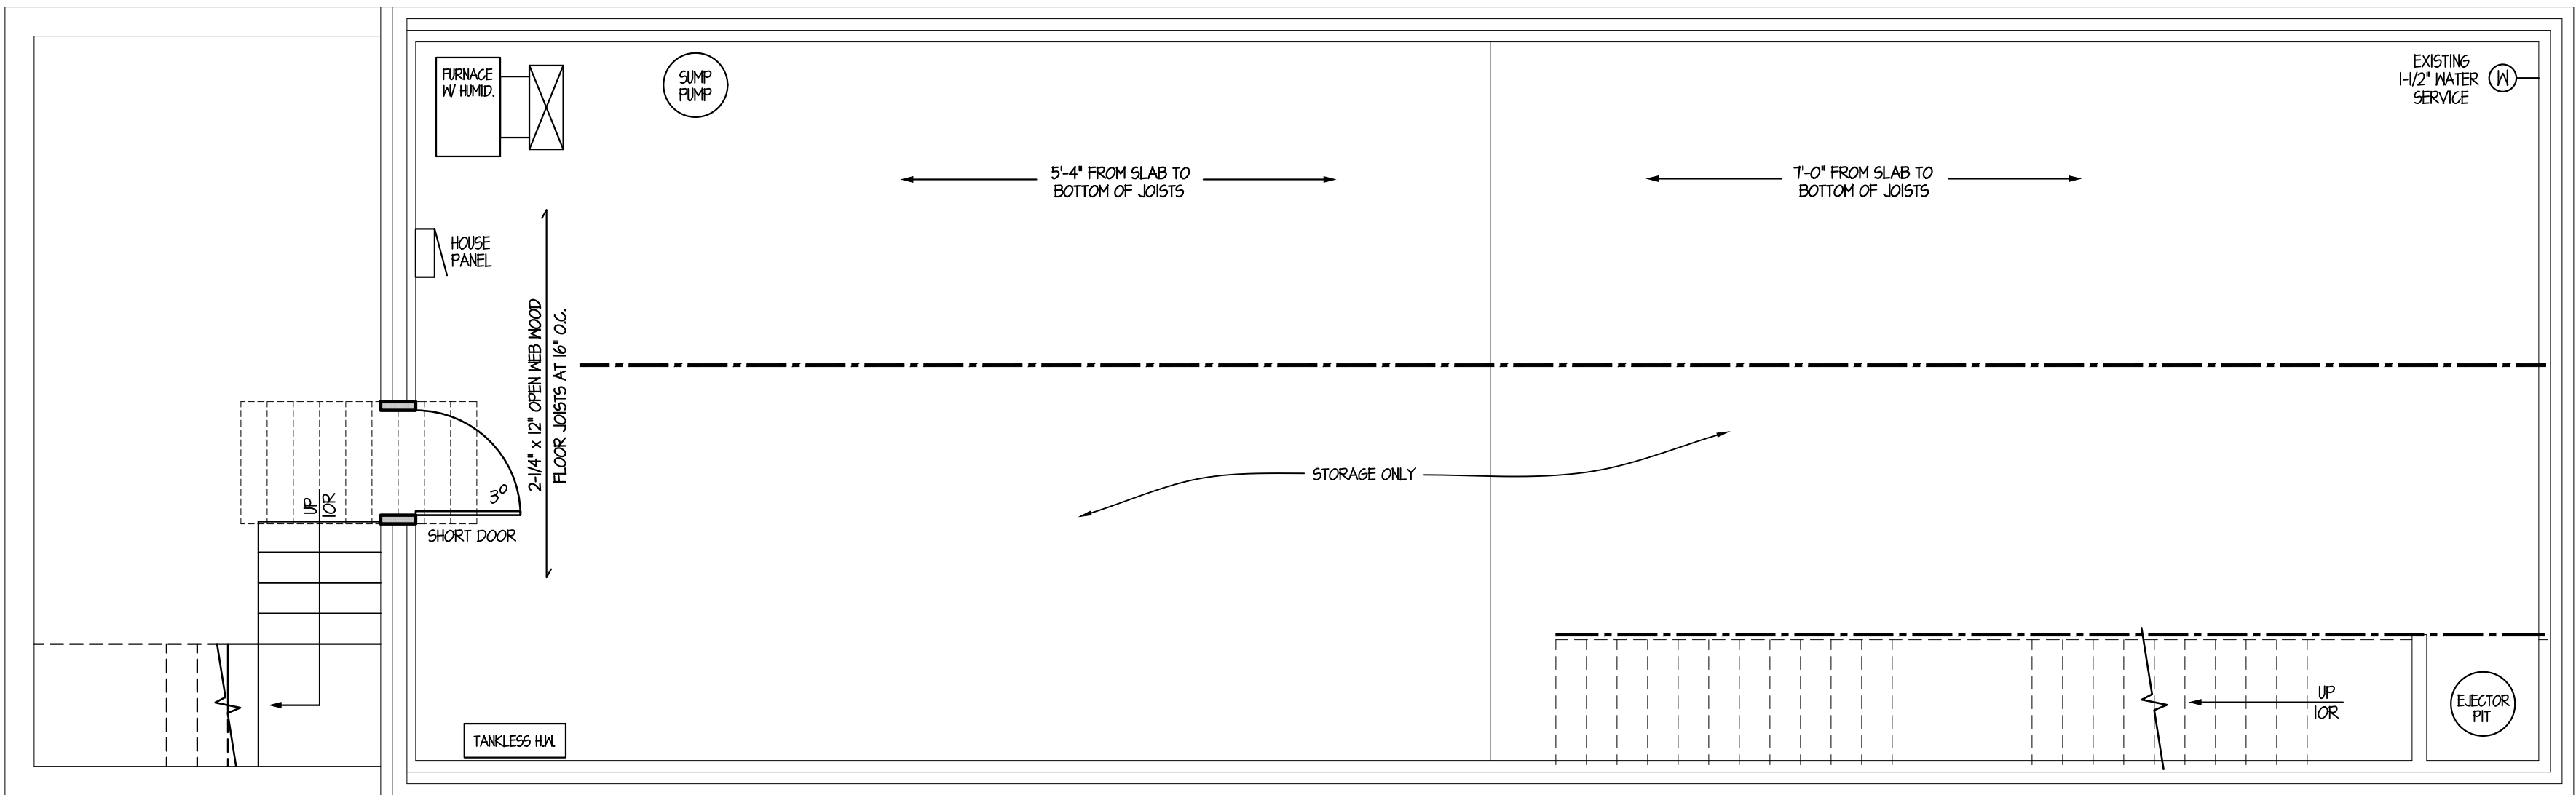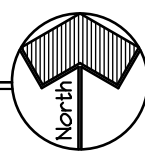

Proposed Basement Plan

Scale: 1/4"=1'-0"

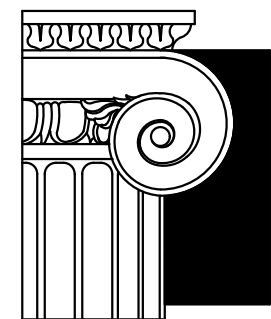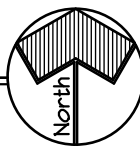

Architects  
By  
Design, PC

109 Ogden Avenue  
Clarendon Hills  
Illinois 60514


(630) 323-9604 (p)  
(630) 323-9615 (f)

randyk@  
architectsbydesign.com

As-Built Plans For:  
**209 N. Chicago Street**  
Joliet, Illinois

File No: 26-3345 Date: 8/25/2026

Checked: R.M.K. Drawn: G.P.

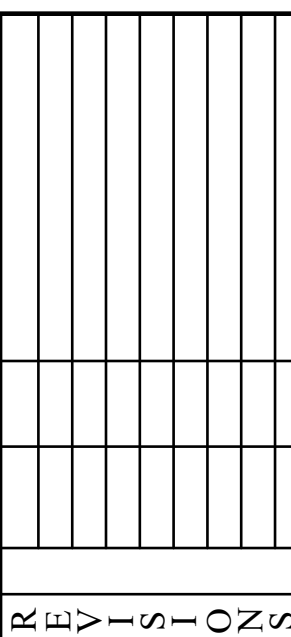


STAMP:

SHEET NO:


OF SHEETS

COPYRIGHT © 2025  
ARCHITECTS BY DESIGN, P.C.




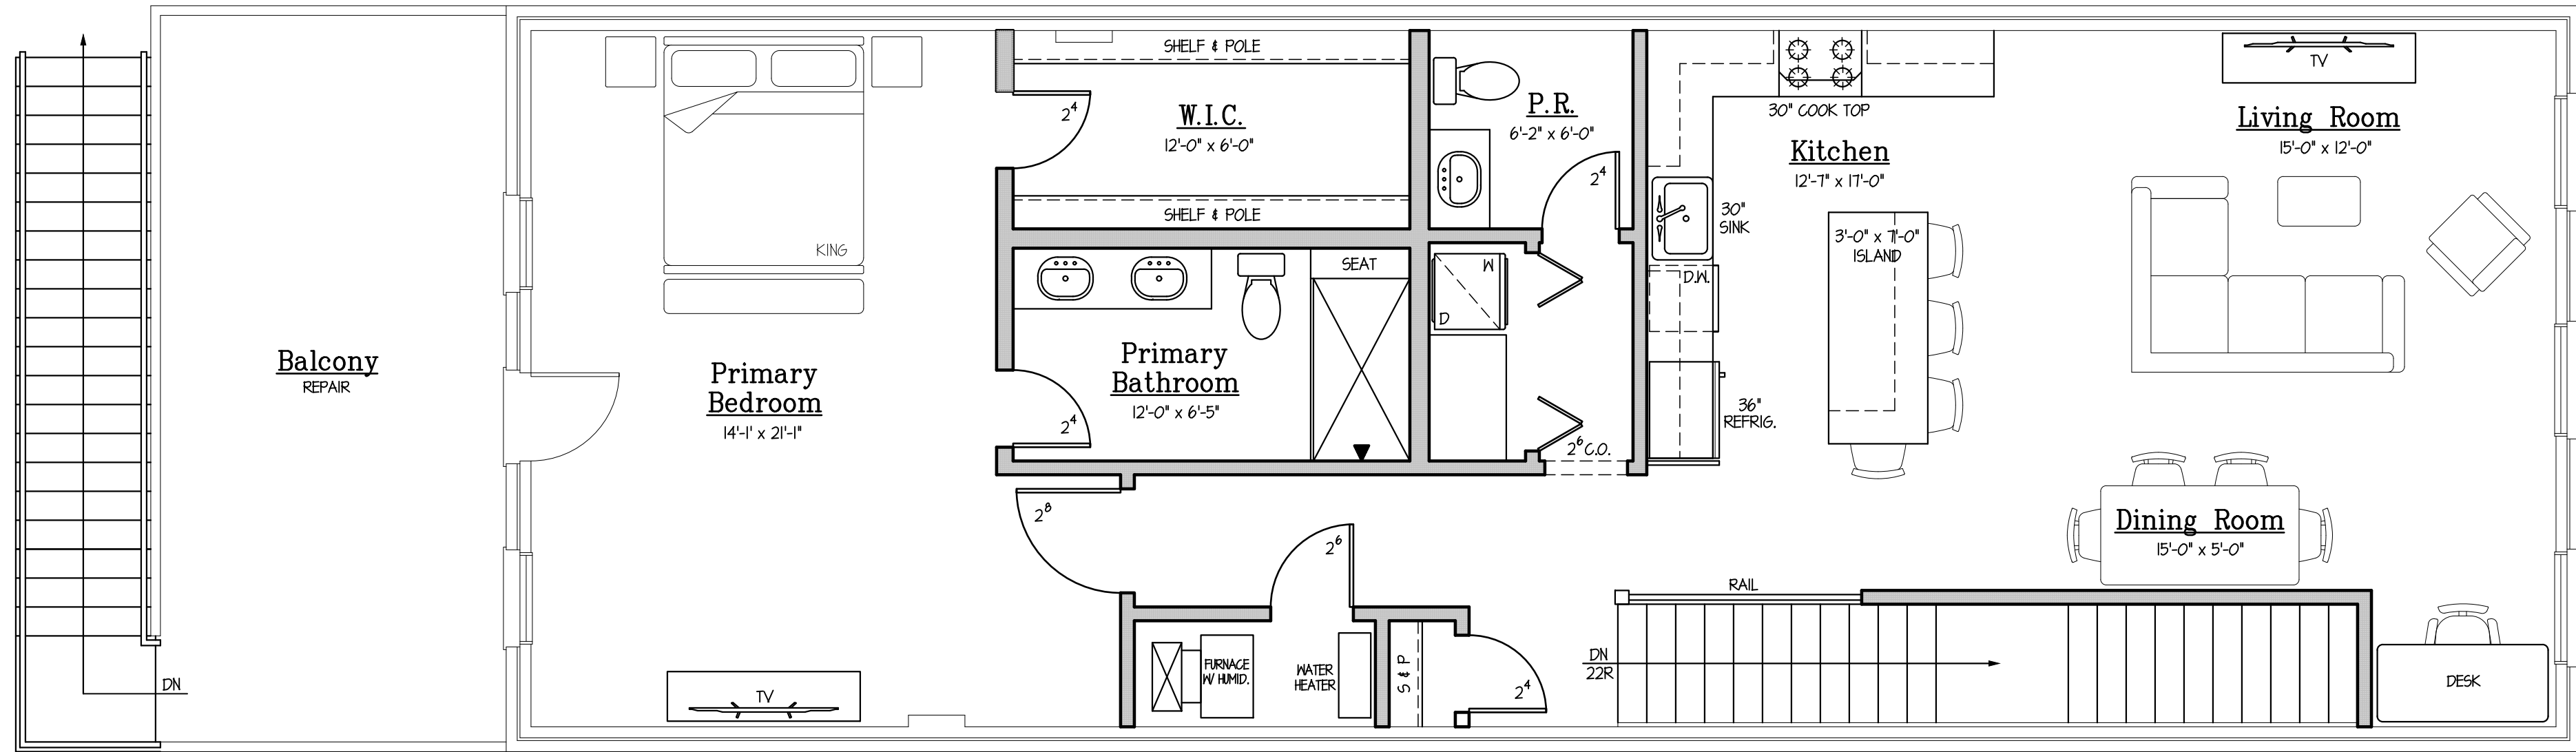

**Proposed Second Floor Plan**  
OPTION: B Scale: 1/4"=1'-0"

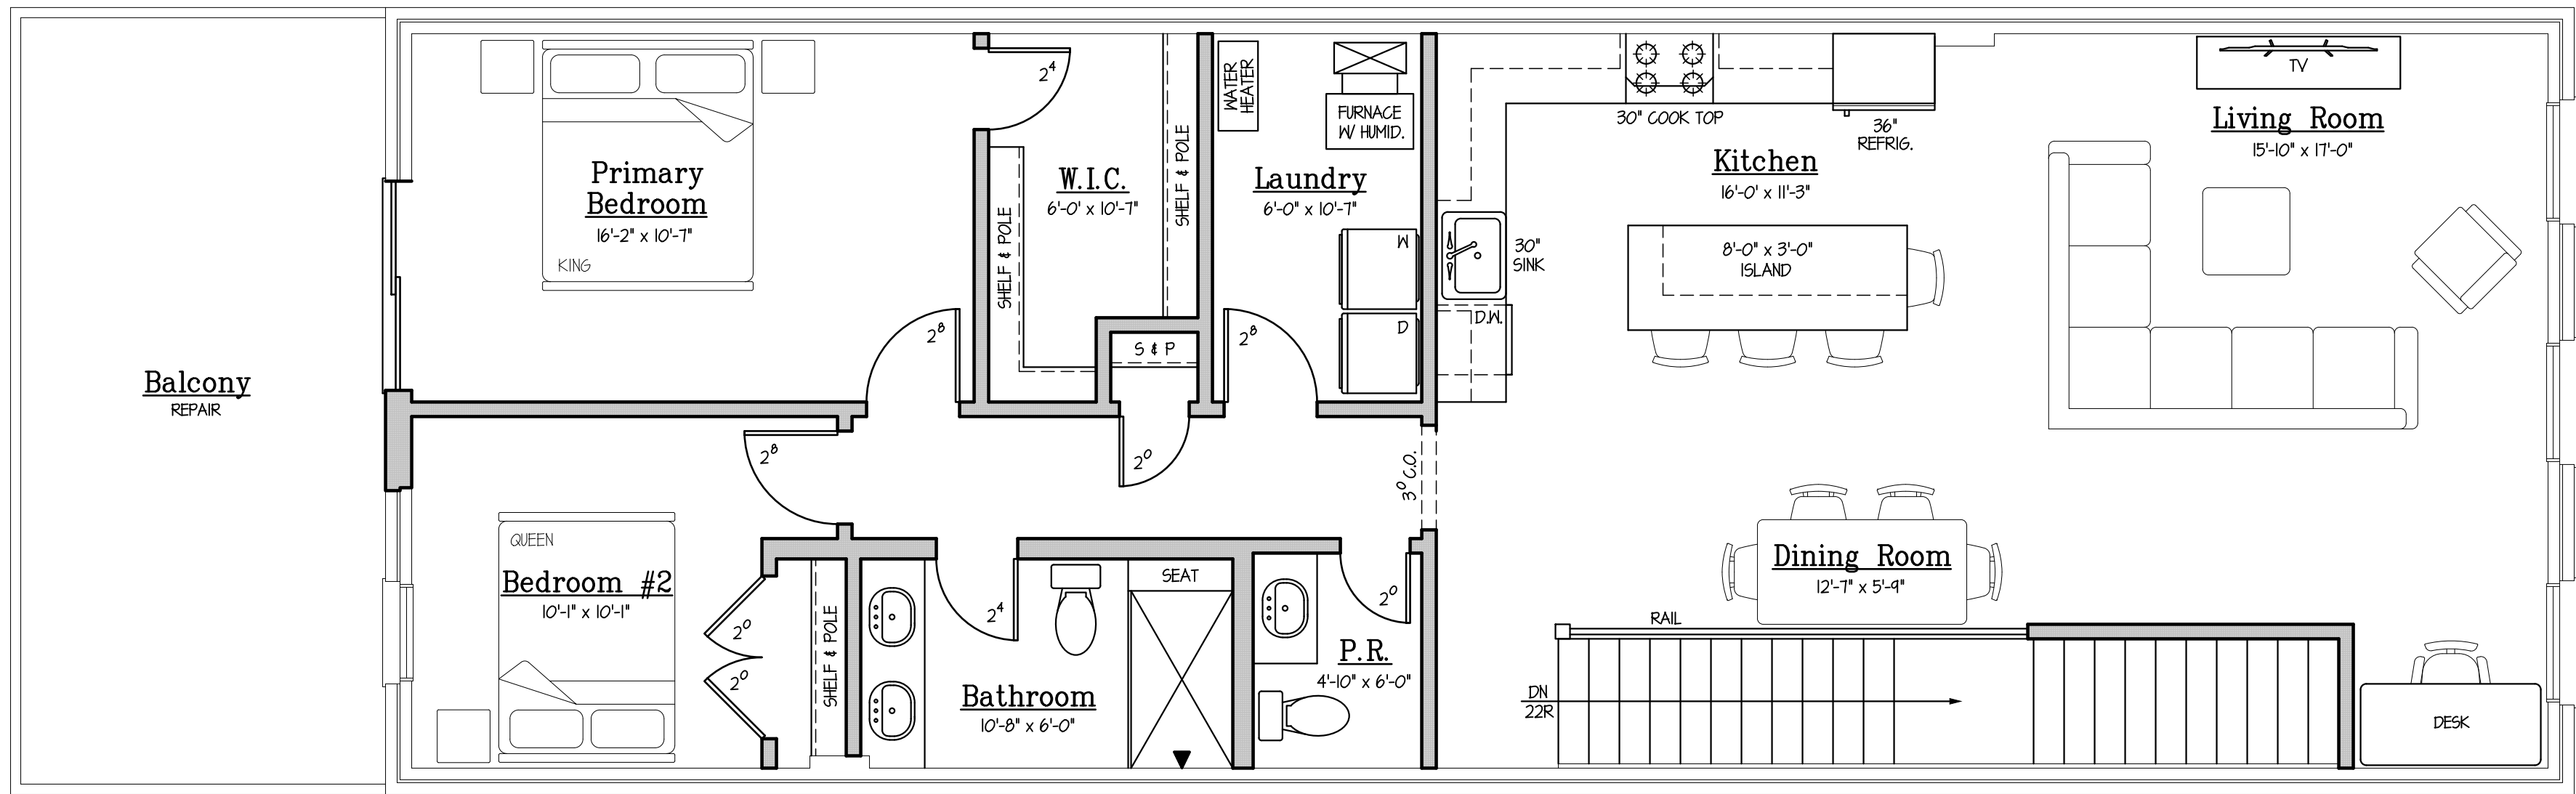

**Proposed Second Floor Plan**  
OPTION: C Scale: 1/4"=1'-0"

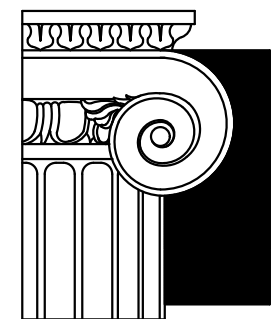

Architects  
By  
Design, PC

109 Ogden Avenue  
Clarendon Hills  
Illinois 60514

(630) 323-9604 (p)  
(630) 323-9615 (f)


randyk@  
architectsbydesign.com

As-Built Plans For:  
**209 N. Chicago Street**

Joliet, Illinois

File No: 26-3345 Date: 8/25/2026

Checked: R.M.K. Drawn: C.P.

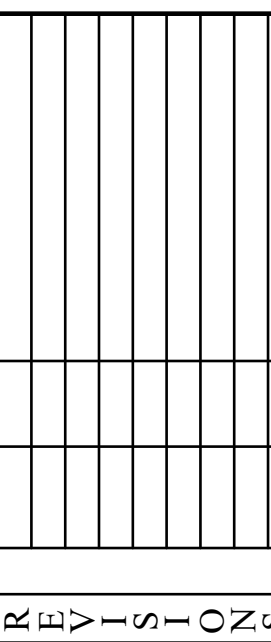

STAMP:

SHEET NO:

OF SHEETS

COPYRIGHT © 2025  
ARCHITECTS BY DESIGN, P.C.