


AS-BUILT FLOOR PLAN - SUITE 100
 SCALE: 1/4" = 1'-0"

1

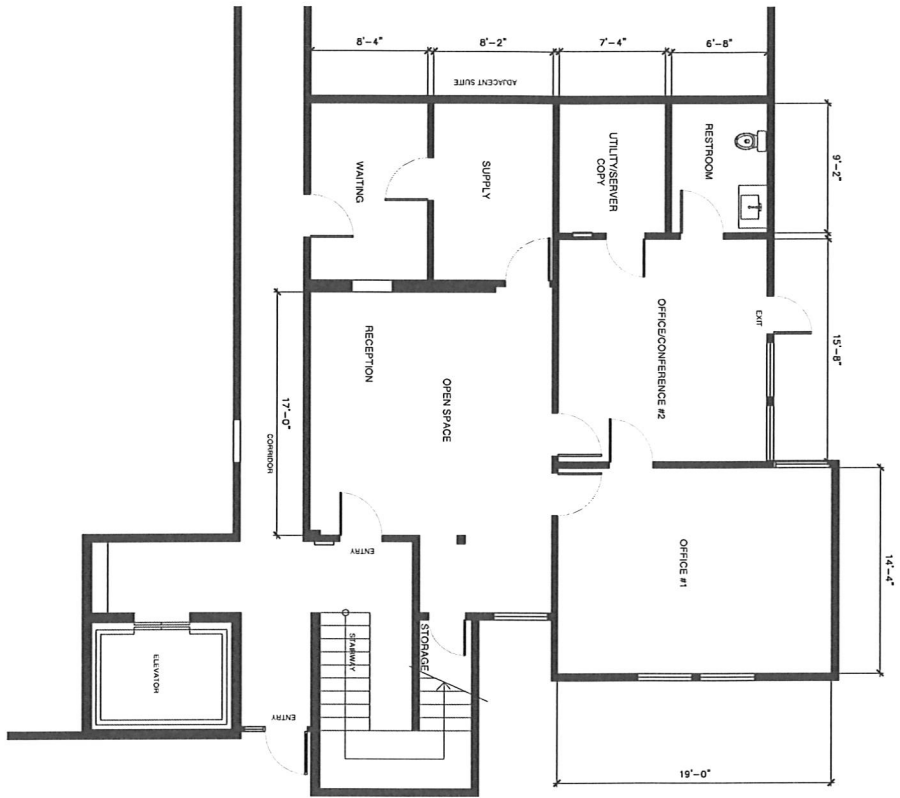

Cre8 Design Plus, LLC.
 2789 TROY CT. #101
 CORONA, CALIFORNIA 92683
 PHONE: 949-326-8497
 EMAIL: info@cre8designplus.com
 WEBSITE: www.cre8designplus.com

REVISIONS:	DATE:	BY:

DESIGNER:
 DESIGN & Prepared by
 Elizabeth Graham
 CLIENT:

STAMP:

PROJECT:

AS-BUILT DRAWINGS
 12752 GARDEN GROVE BLVD, STE. 100
 GARDEN GROVE, CA. 92843

TITLE: EXISTING FLOOR PLAN - DIMENSIONED

DATE: APRIL 01, 2022
 SCALE: AS NOTED
 DRAWN: EAG
 JOB NO: PM22-12752G100
 SHEET:

A1.0D