


NOTE

THIS DRAWING IS RECORD OF REAL PROPERTY THAT IS GENERALLY ACCEPTED TO BE SUITABLE FOR USE IN PLANNING, DESIGN, LEASE, AND GENERAL ASSET MANAGEMENT. IT SHOULD NOT BE USED TO BE USED TO DETERMINE EXACT MEASUREMENTS OF SPACES OR ARTIFACTS FOUND HEREIN FOR ANY PROPOSE.

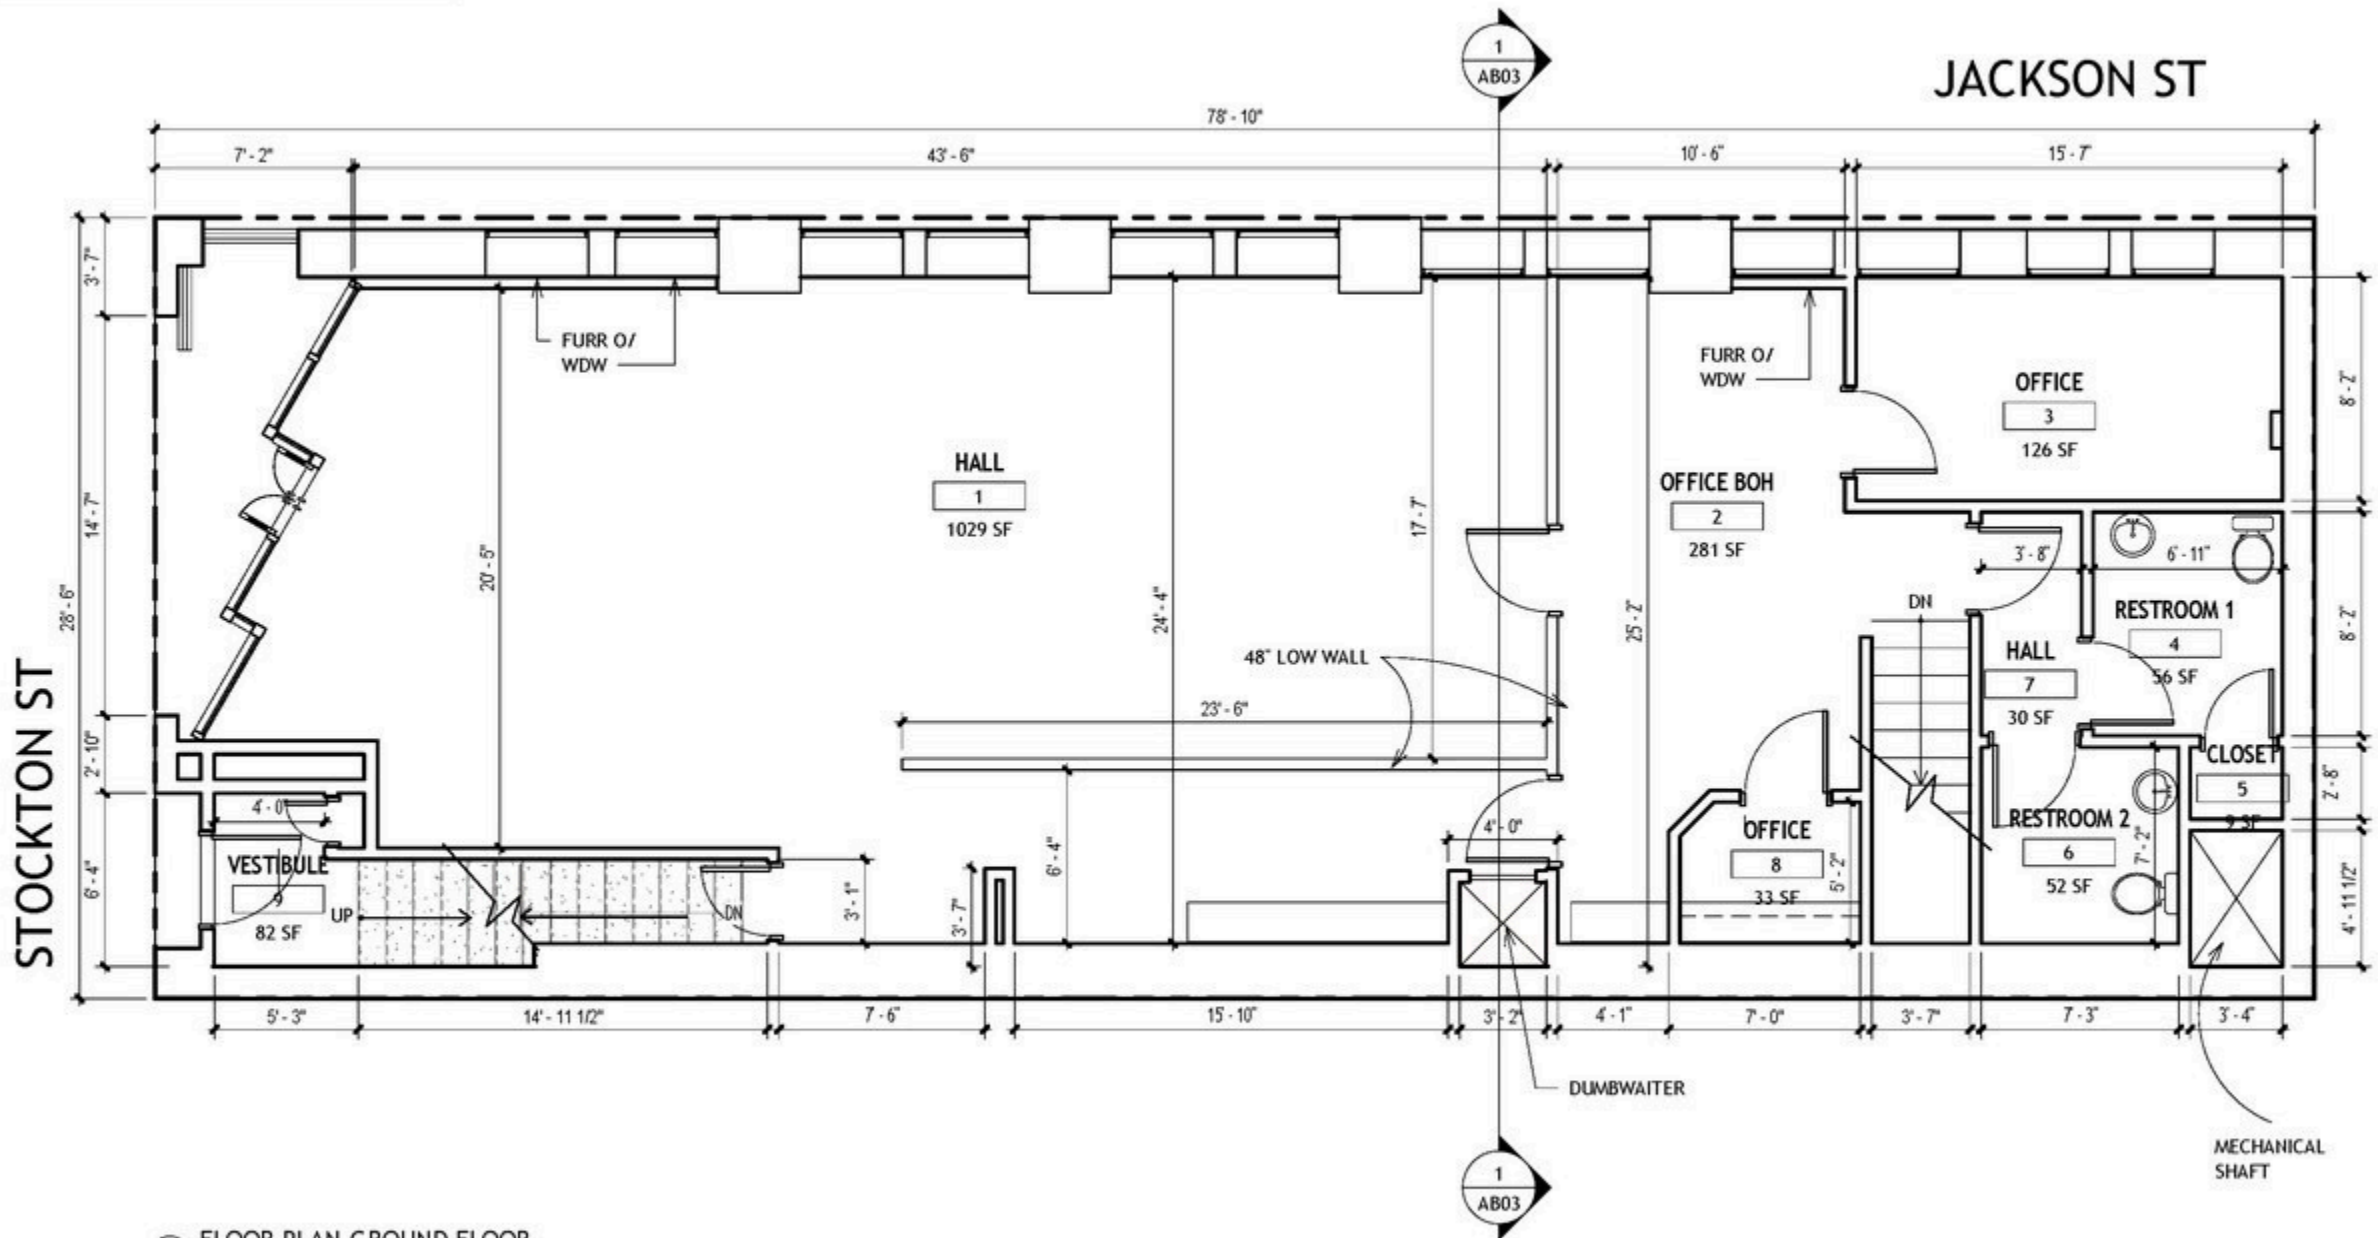

① FLOOR PLAN-GROUND FLOOR
3/16" = 1'-0"

GROUND FLOOR -AS-BUILT