


Scottsdale City Center

7201 East Camelback Road

Suite 216 - 1,268 RSF

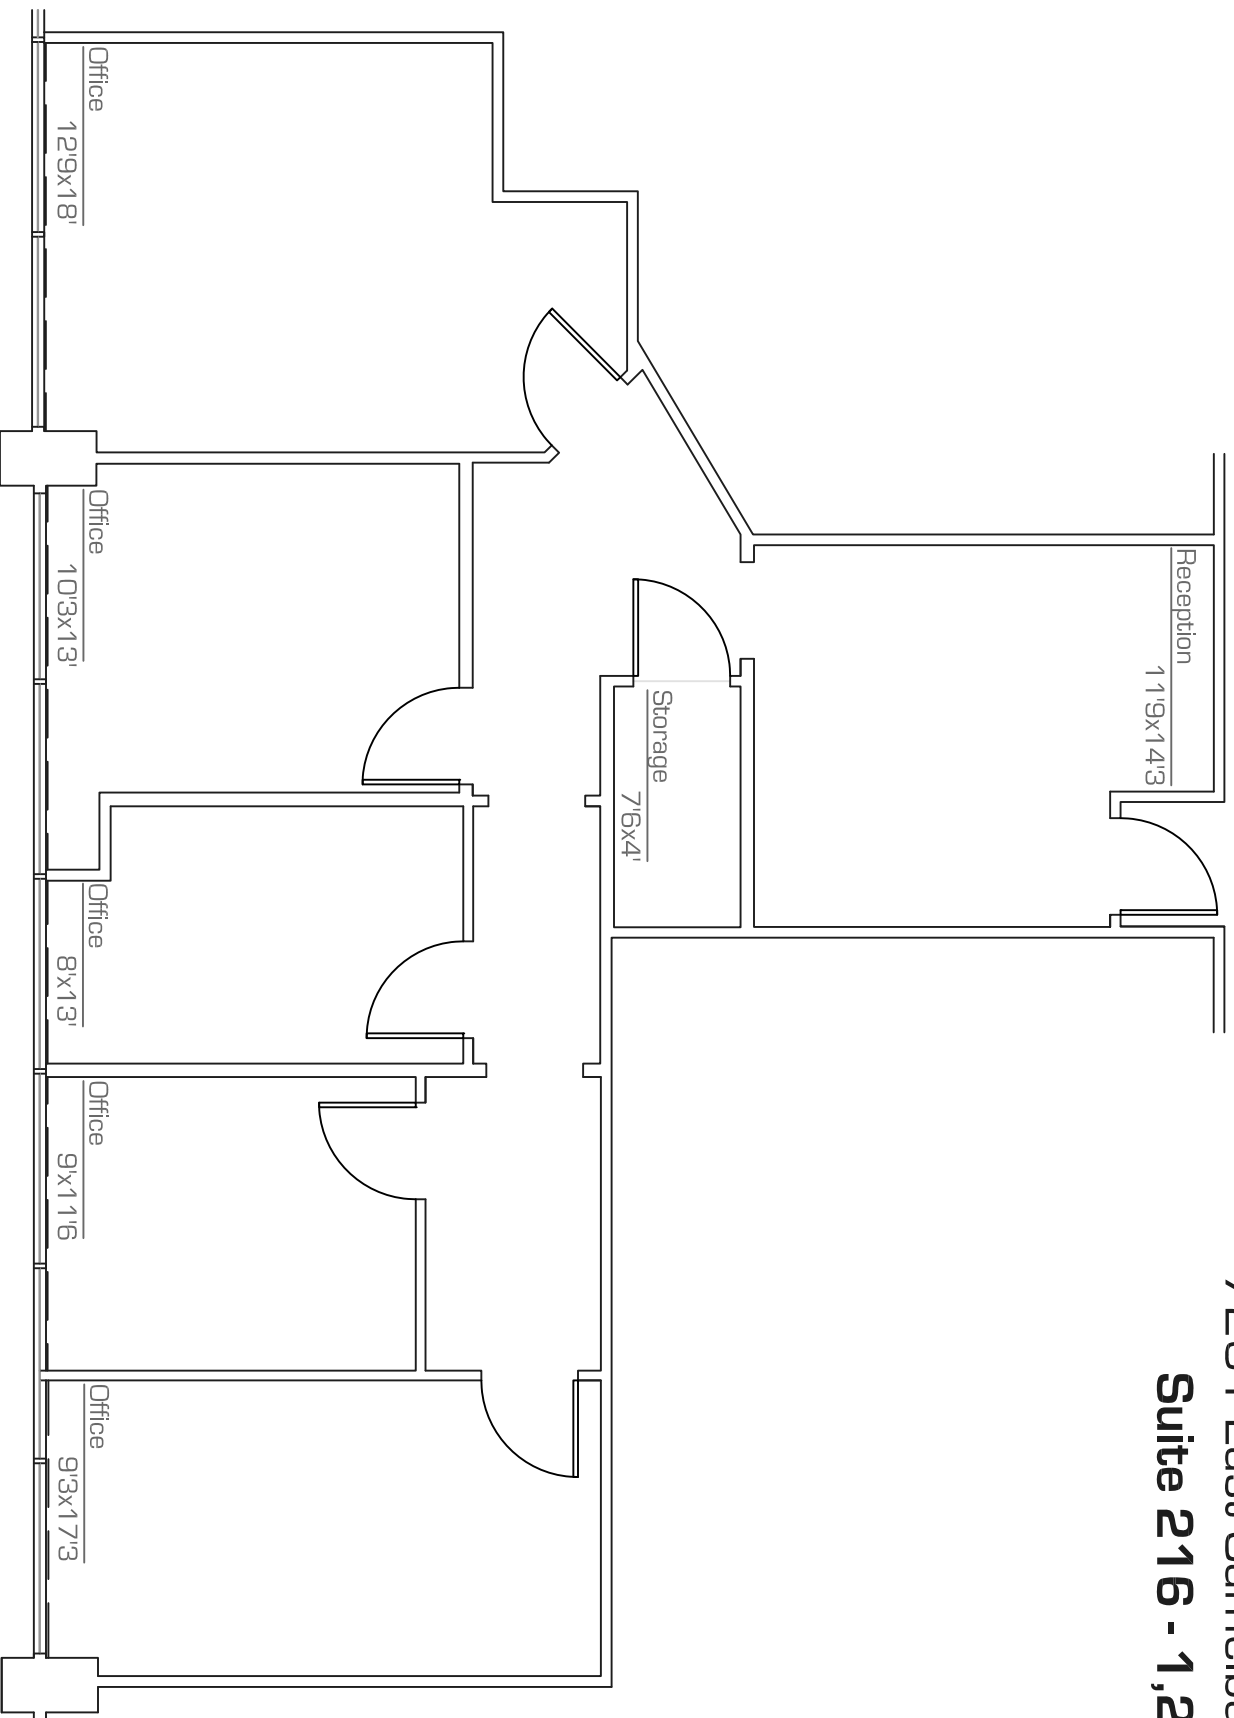

as-built

scale: nts

15.July.2008

*All dimensions are approximate and all information is of general nature.



precision **DIMENSIONS**

as-built . space plans
architectural design

602.790.6412

