


Scottsdale City Center

7201 East Camelback Road . Scottsdale

Suite 212/216 - 2,519 RSF

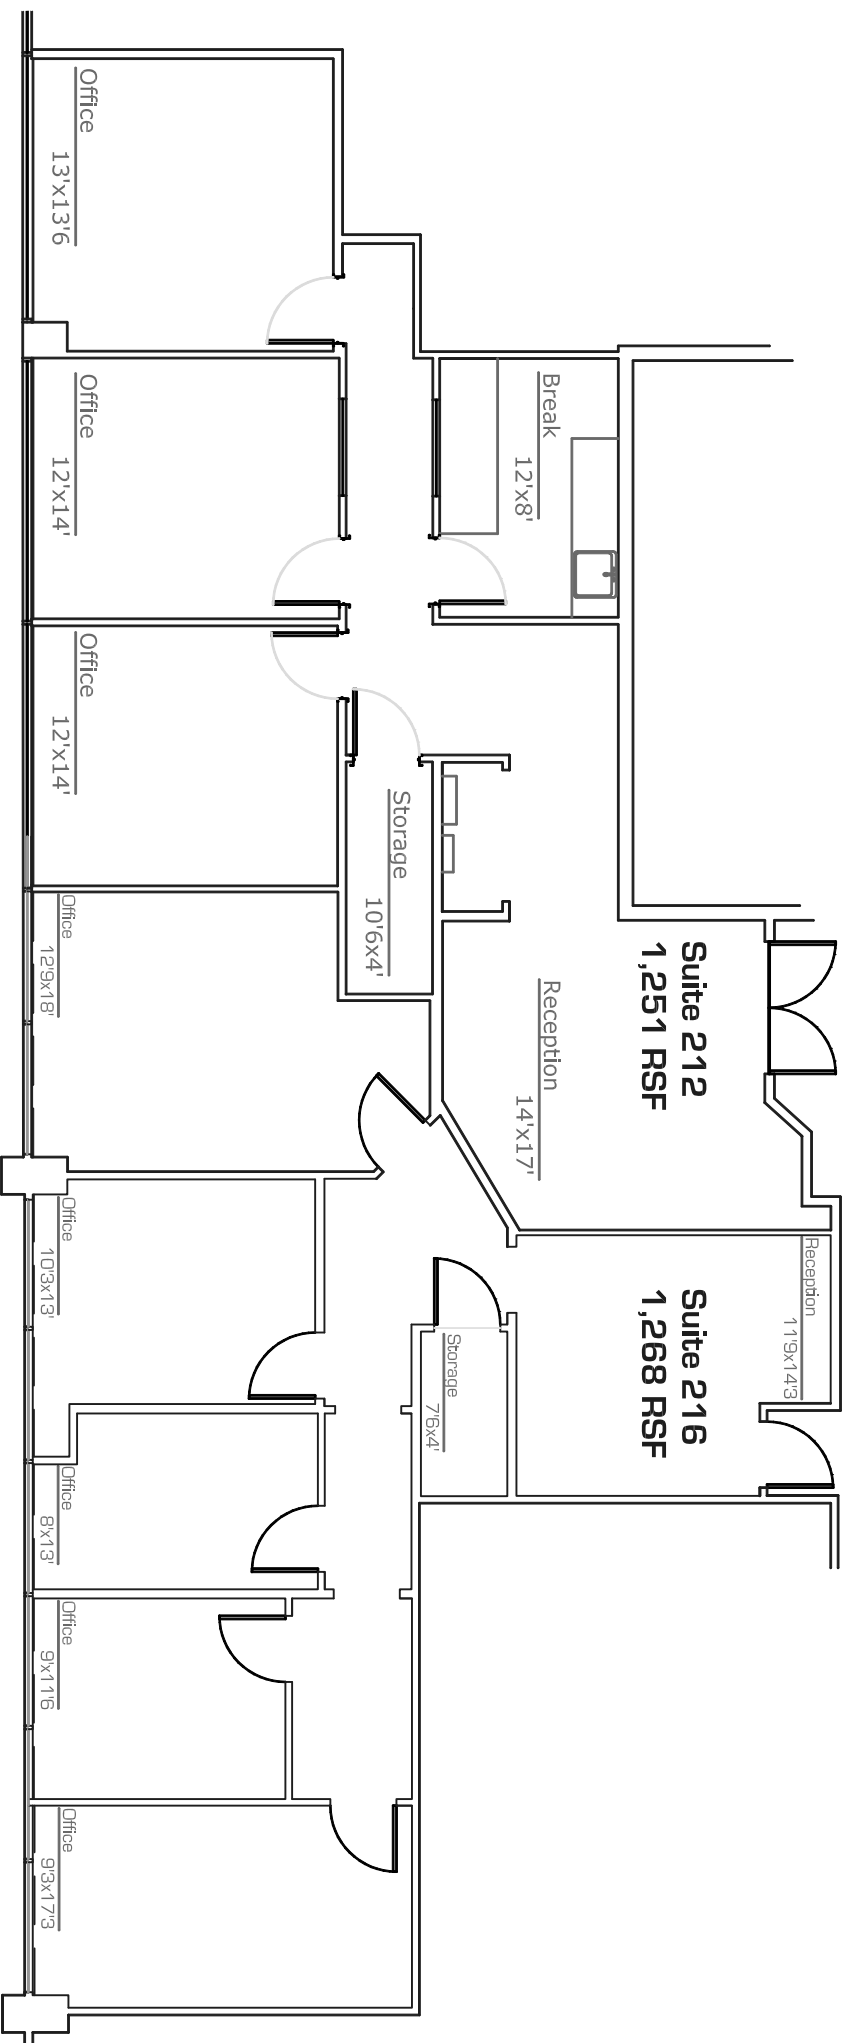

as-built

scale: nts

14.june.2006

*All dimensions are approximate and all information is of general nature.

precision **DIMENSIONS**



as-built . space plans
architectural design

602.790.6412