


As-Built Drawing For:  
**Pearl Street Project**

1312-1318 S Peoria  
Tulsa, OK

**Scale**  
1/16" = 1'-0"

**Sheet Content**  
1318 S Peoria-South Building  
1312 S Peoria-North Building

**Sheet Number**  
**A-1**  
Date: 11/15/2016

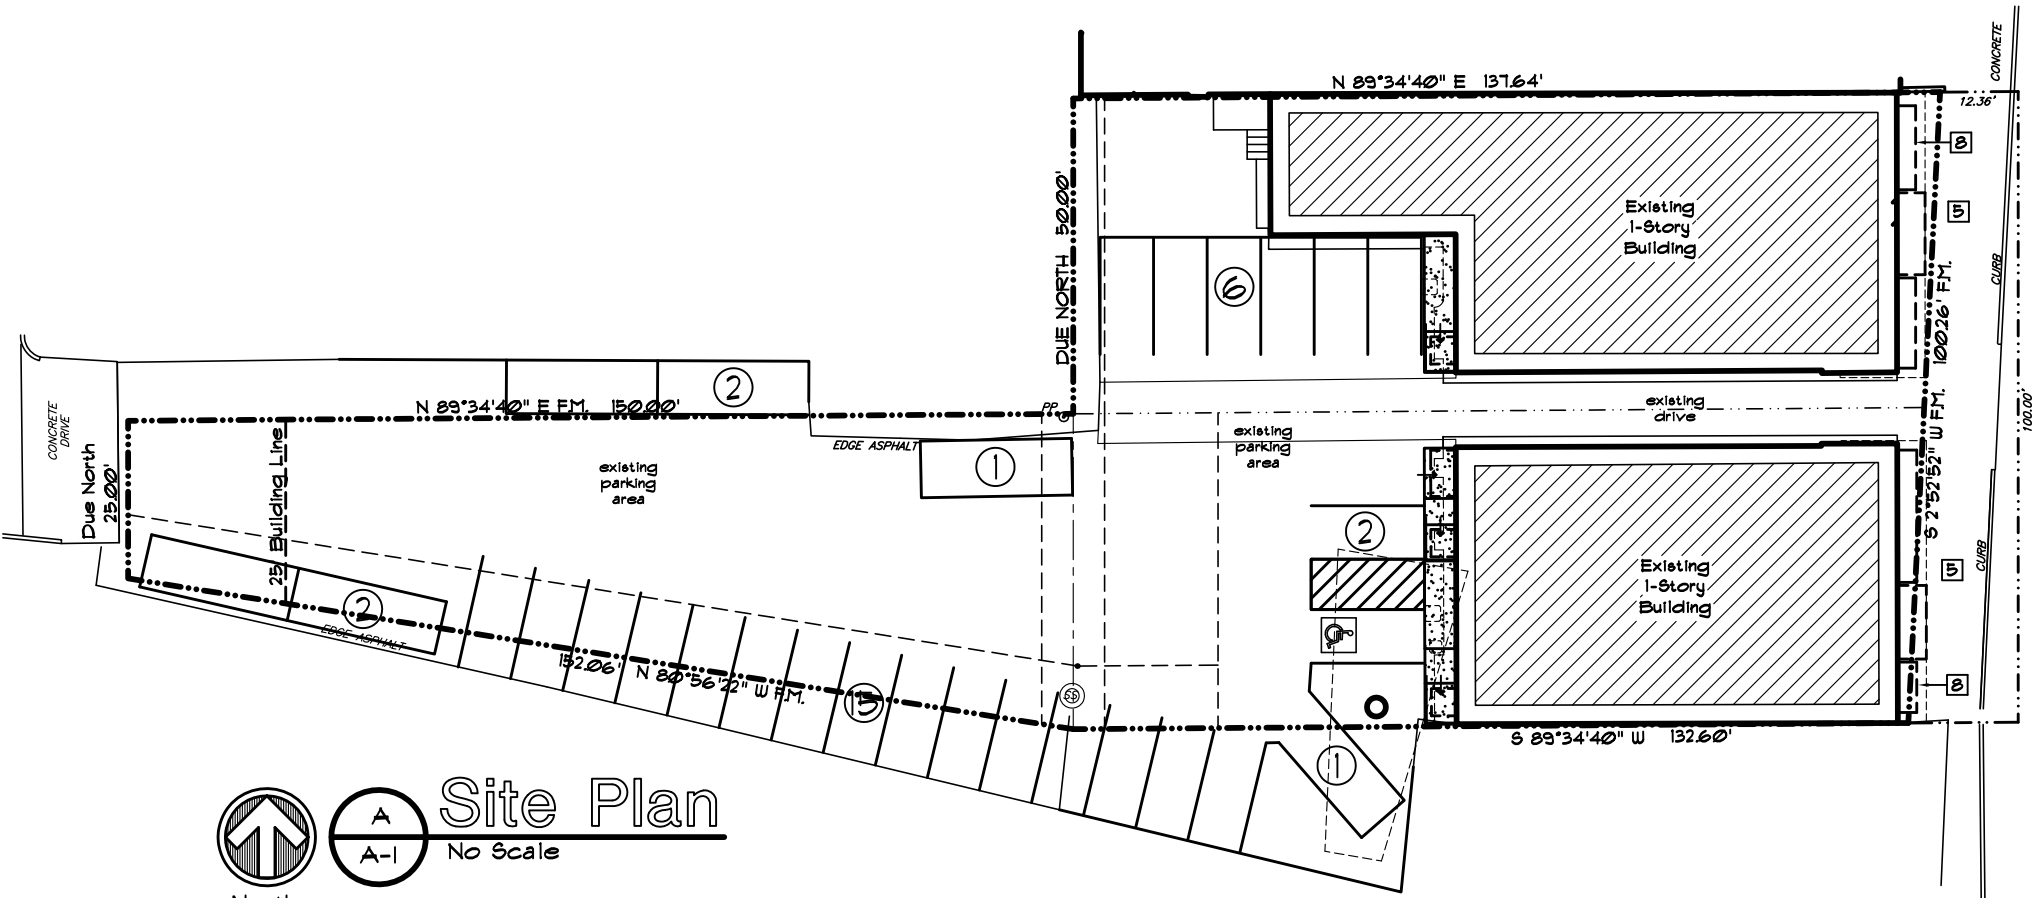



**Site Plan**  
 No Scale  
 29 Parking Spaces