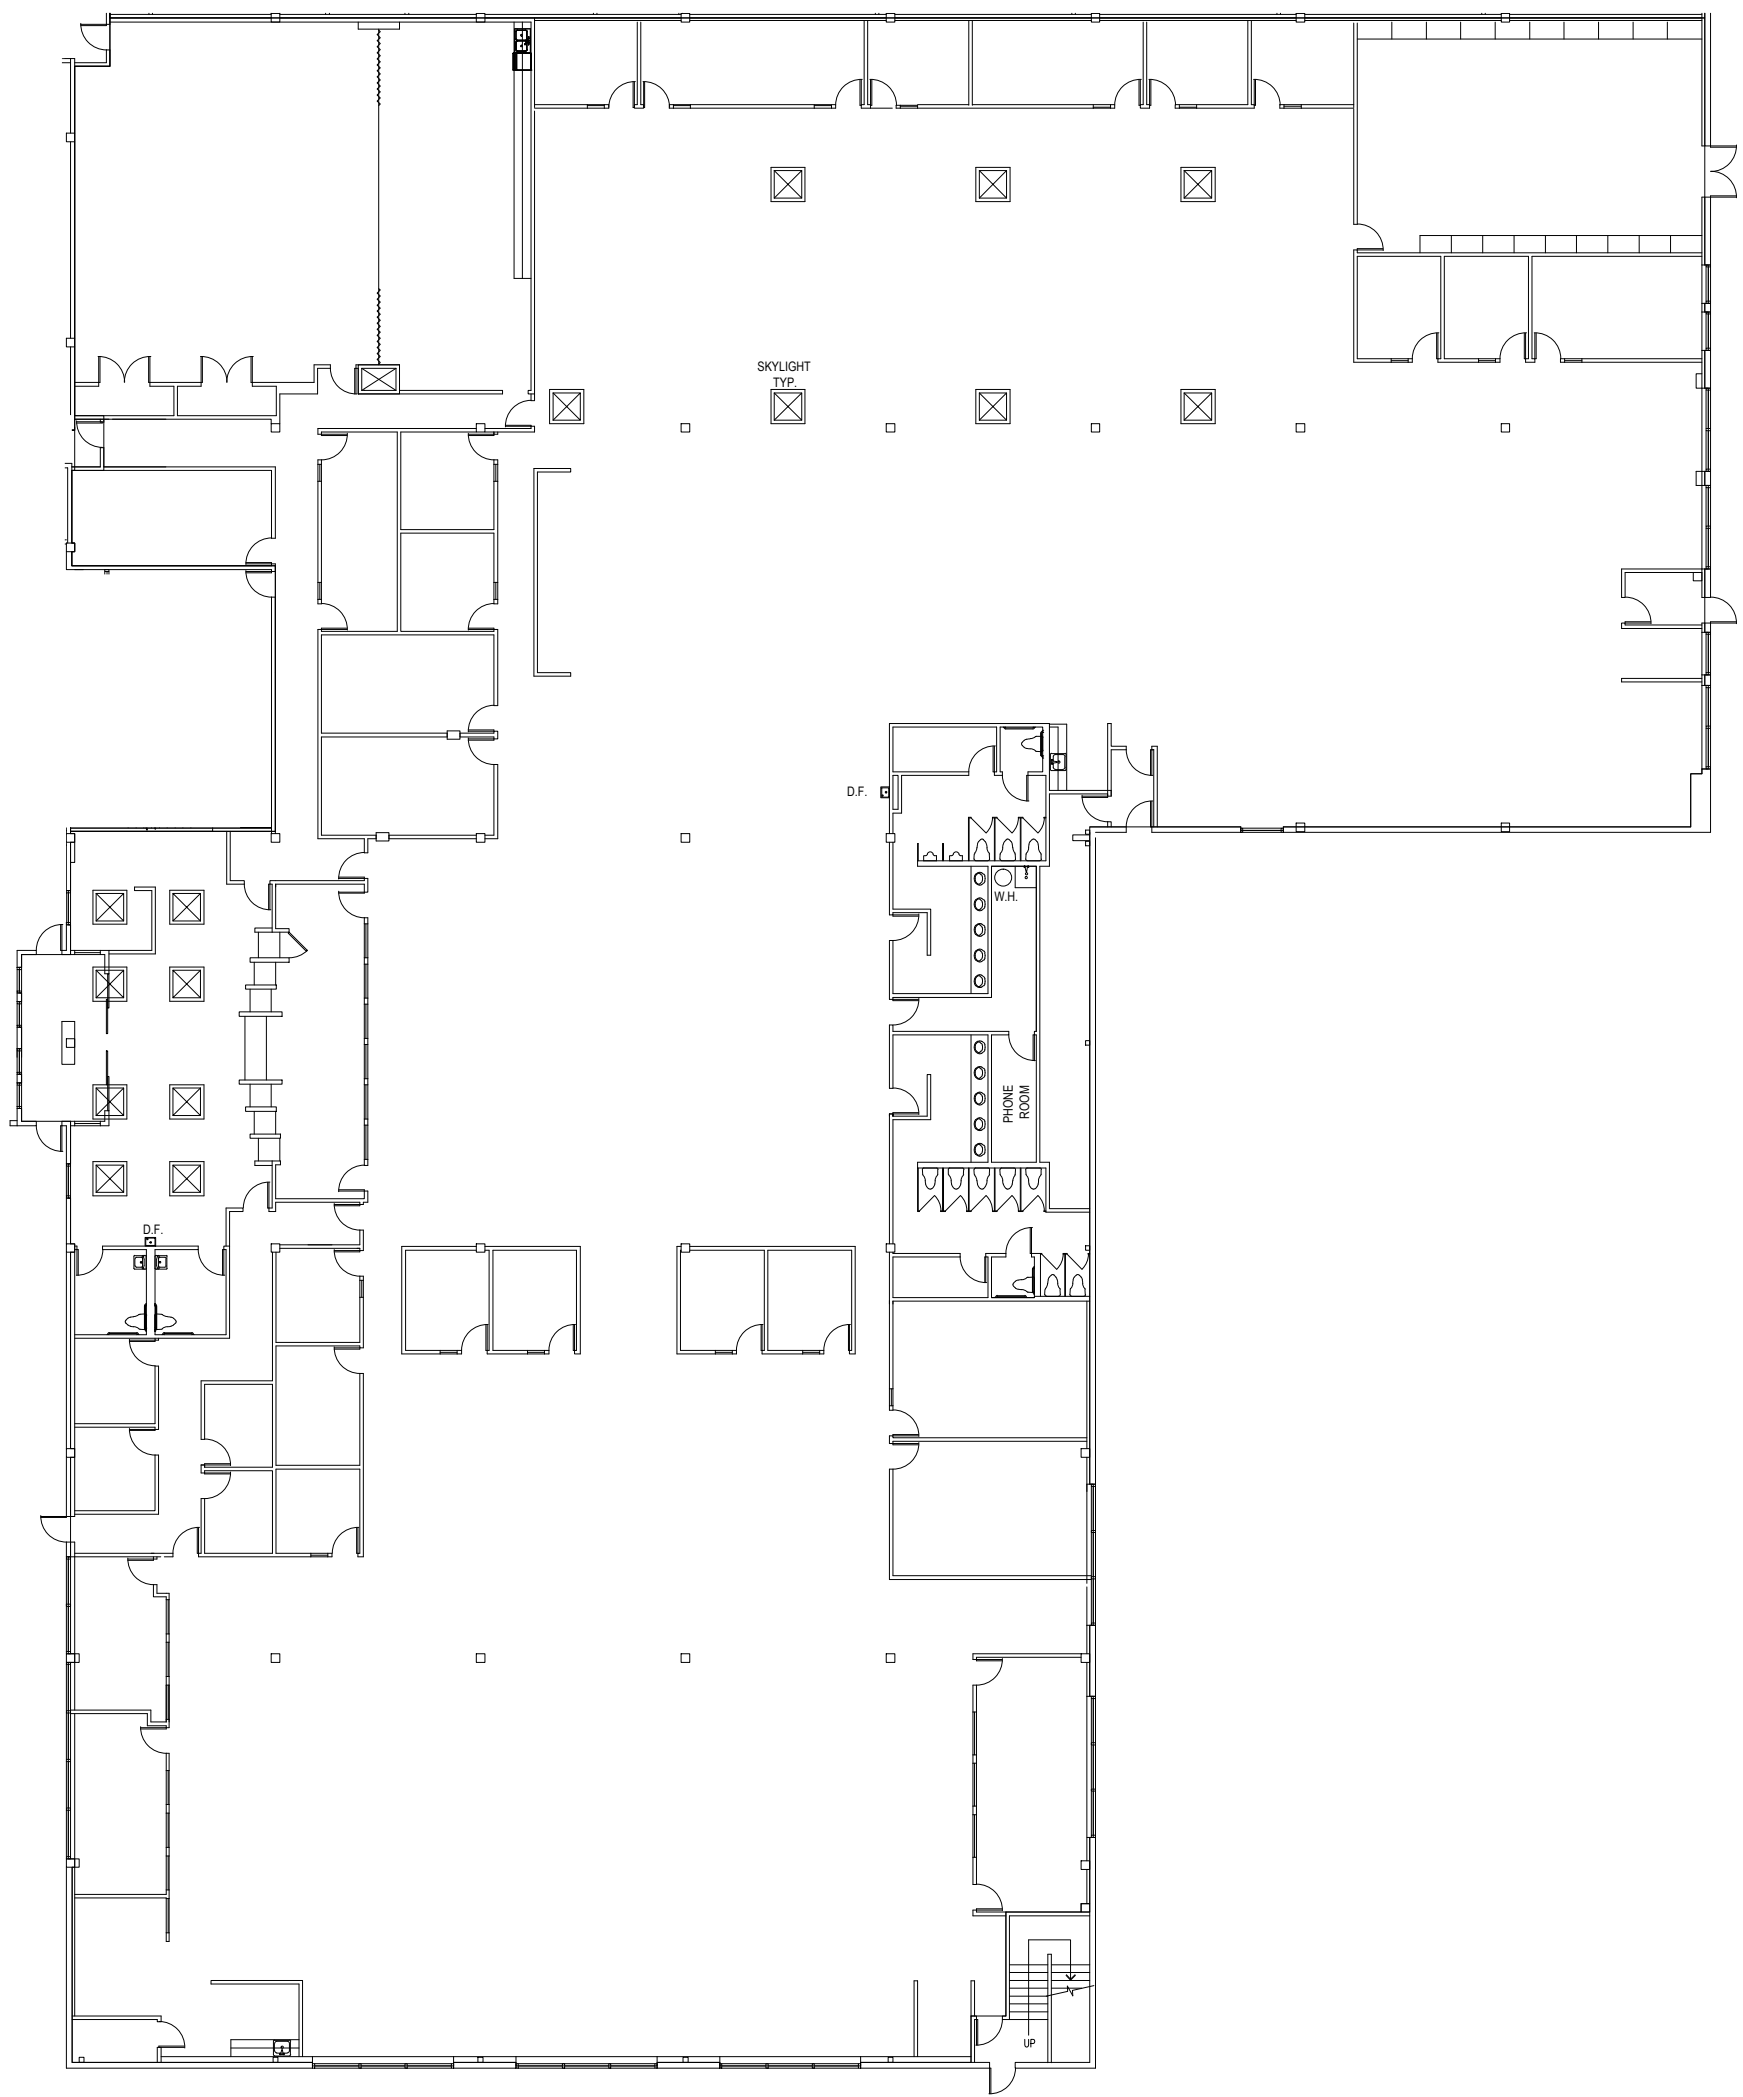


SUITE 'X' AS-BUILT

SCALE: NTS = 1'-0"

34,511 USF

[TKA] space planning/commercial renovation/
interior design/dental/medical

1327 SE Division St.
Portland Oregon 97202

ph: 503 235 0243
fx : 503 546 5698

TONI KING & ASSOCIATES

AS-BUILT FOR:
TOWN PLAZA
SUITE 'X'
5311 E MILL PLAIN BLVD
VANCOUVER, WA

DATE:	9.23.2016
FILE:	2016-24-00
JOB:	2016-24-01
DWN:	--
CHK:	--

A1.1