


COPYRIGHT © J. H. DRAFTING & DESIGN, INC. ALL RIGHTS RESERVED. THIS DRAWING IS THE PROPERTY OF J. H. DRAFTING & DESIGN, INC. AND IS NOT TO BE REPRODUCED OR TRANSMITTED IN ANY FORM OR BY ANY MEANS, ELECTRONIC OR MECHANICAL, INCLUDING PHOTOCOPYING, RECORDING, OR BY ANY INFORMATION STORAGE AND RETRIEVAL SYSTEM. WITHOUT PERMISSION IN WRITING FROM J. H. DRAFTING & DESIGN, INC. ANY REPRODUCTION OR TRANSMISSION OF THIS DRAWING IS STRICTLY PROHIBITED AND FORBIDDEN.

DATE: JULY 23, 2026
 PROJECT: PETROLEUM CENTER
 JOB # JH26007

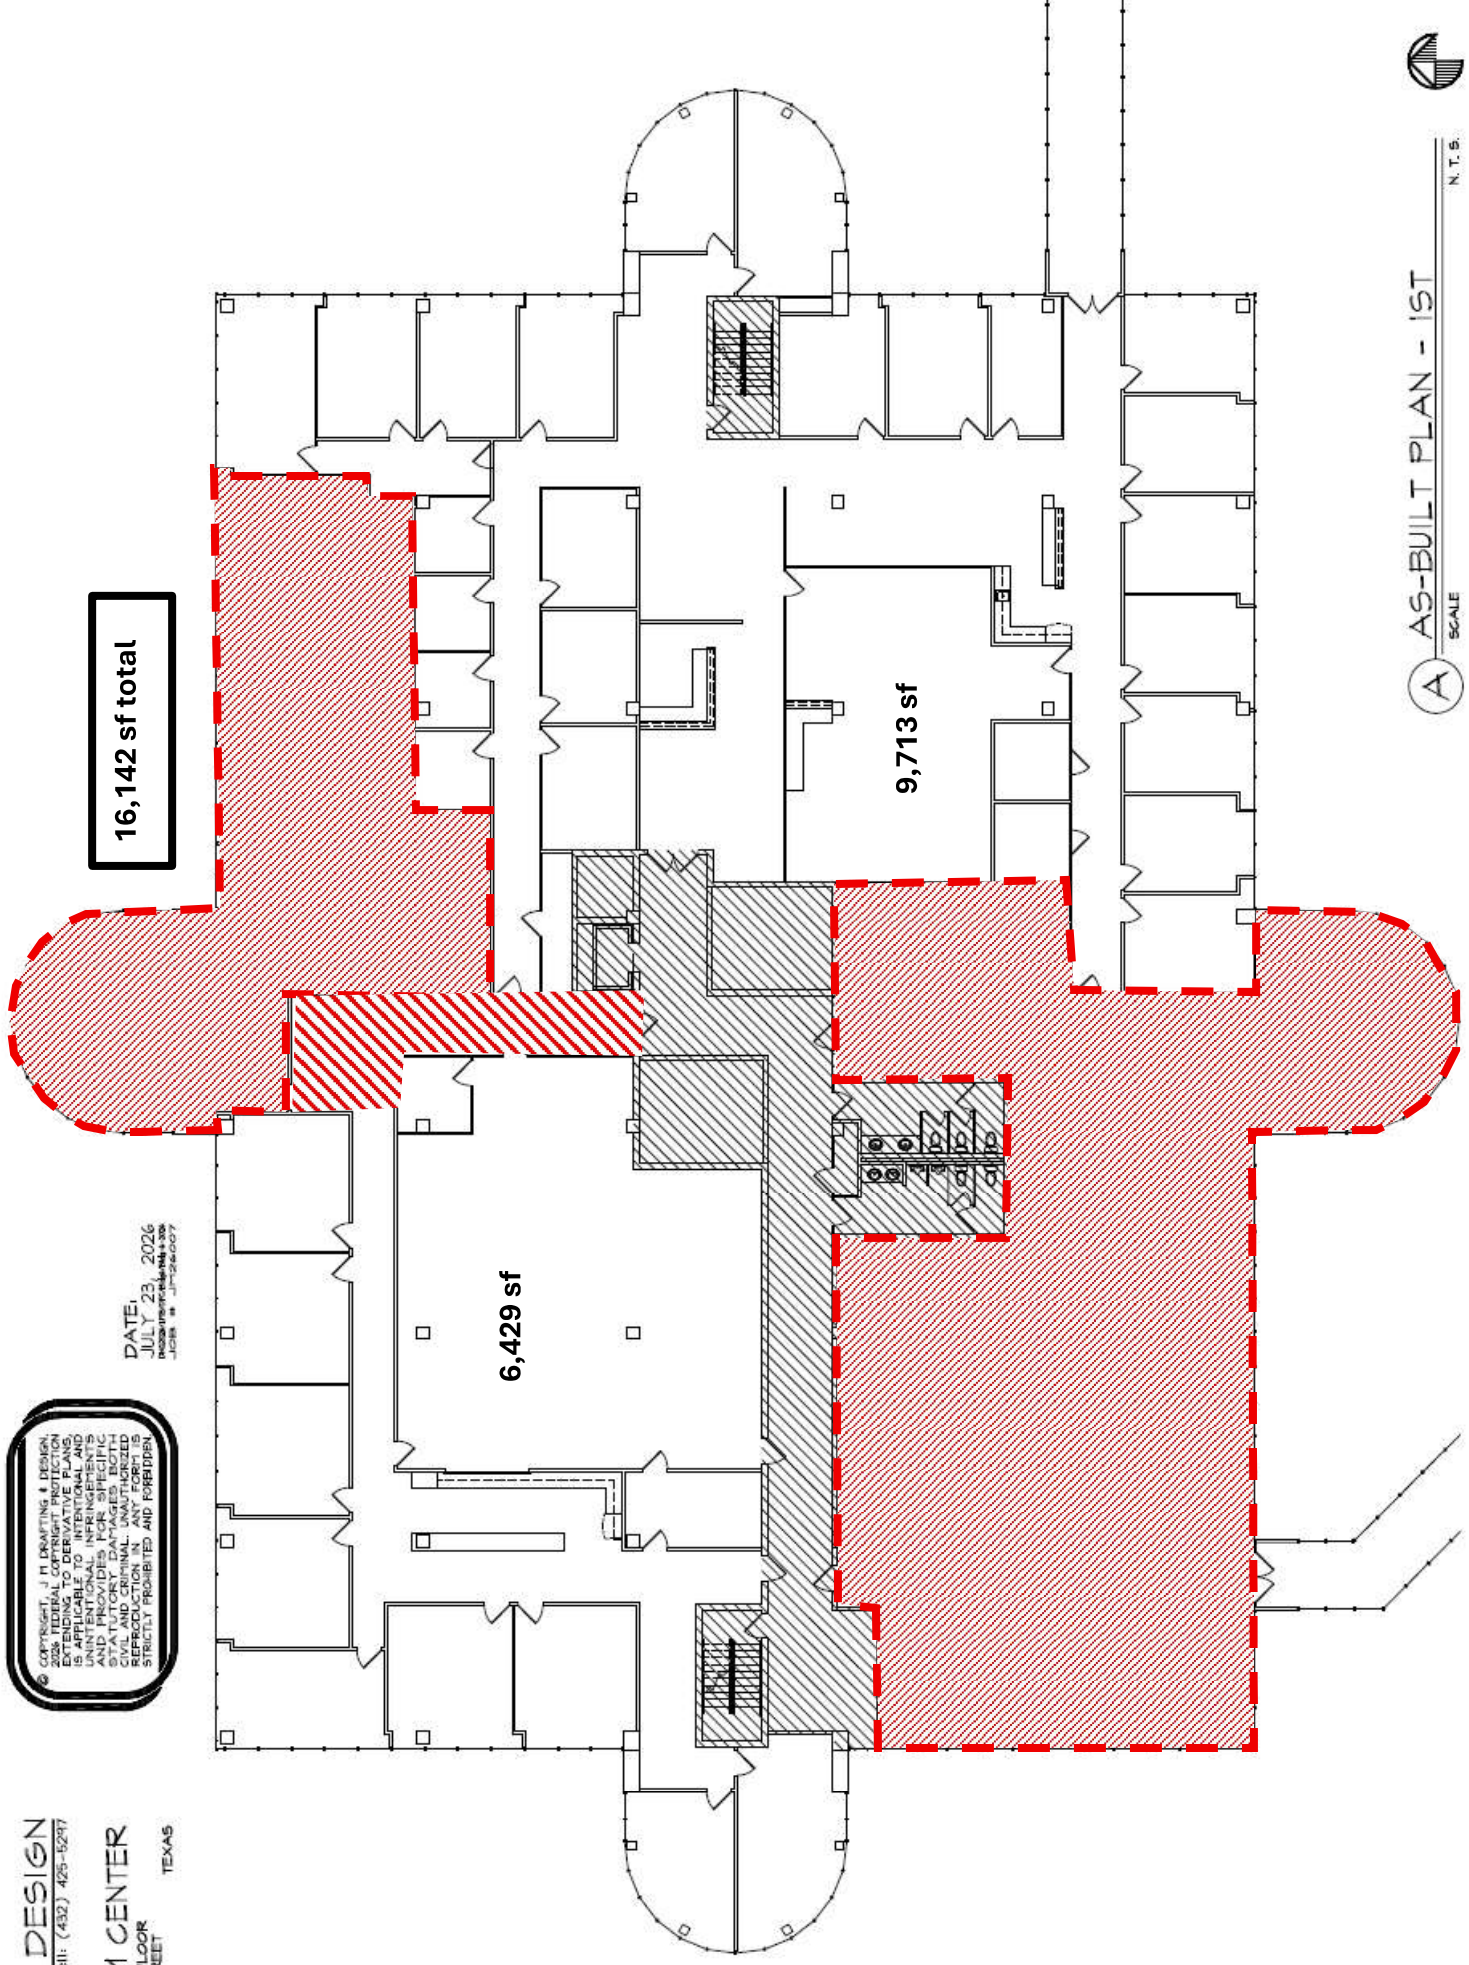

A AS-BUILT PLAN - 1ST
 SCALE
 N.T.S.