



**PBV Architects, LLC**  
 12361 E. Cornell Ave ♦ Aurora, CO 80014  
 (P) 303.699.6789 ♦ paul@pbva.net ♦ (F) 303.484.7750

**AFFILIATED REAL ESTATE GROUP, LLC**  
 COMMERCIAL REAL ESTATE SERVICES

**EXCHANGE BUILDING**  
**Main Level East Wing Floor Plan**  
 19590 East Mainstreet Parker, Colorado


DRAWN: 07.22.09  
 REVISED:  
 SHEET: SP-1.1B

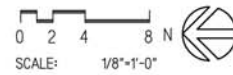


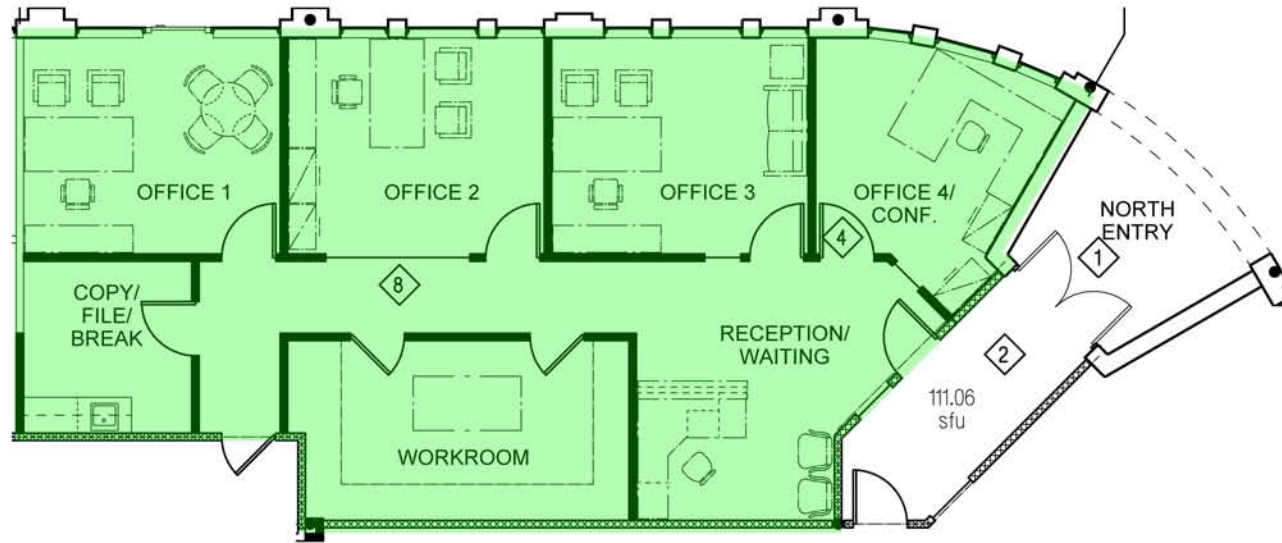

**1,752 RSF**



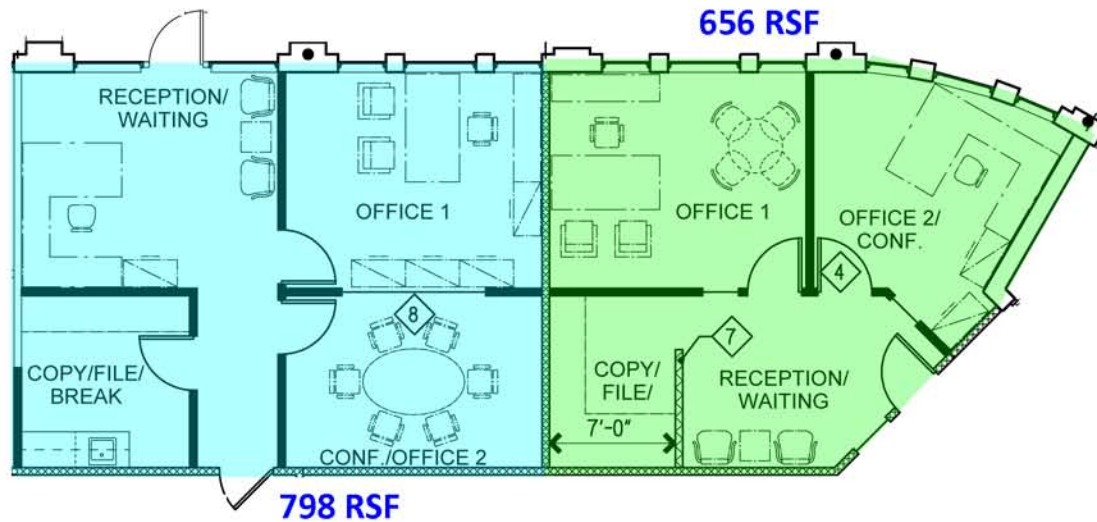

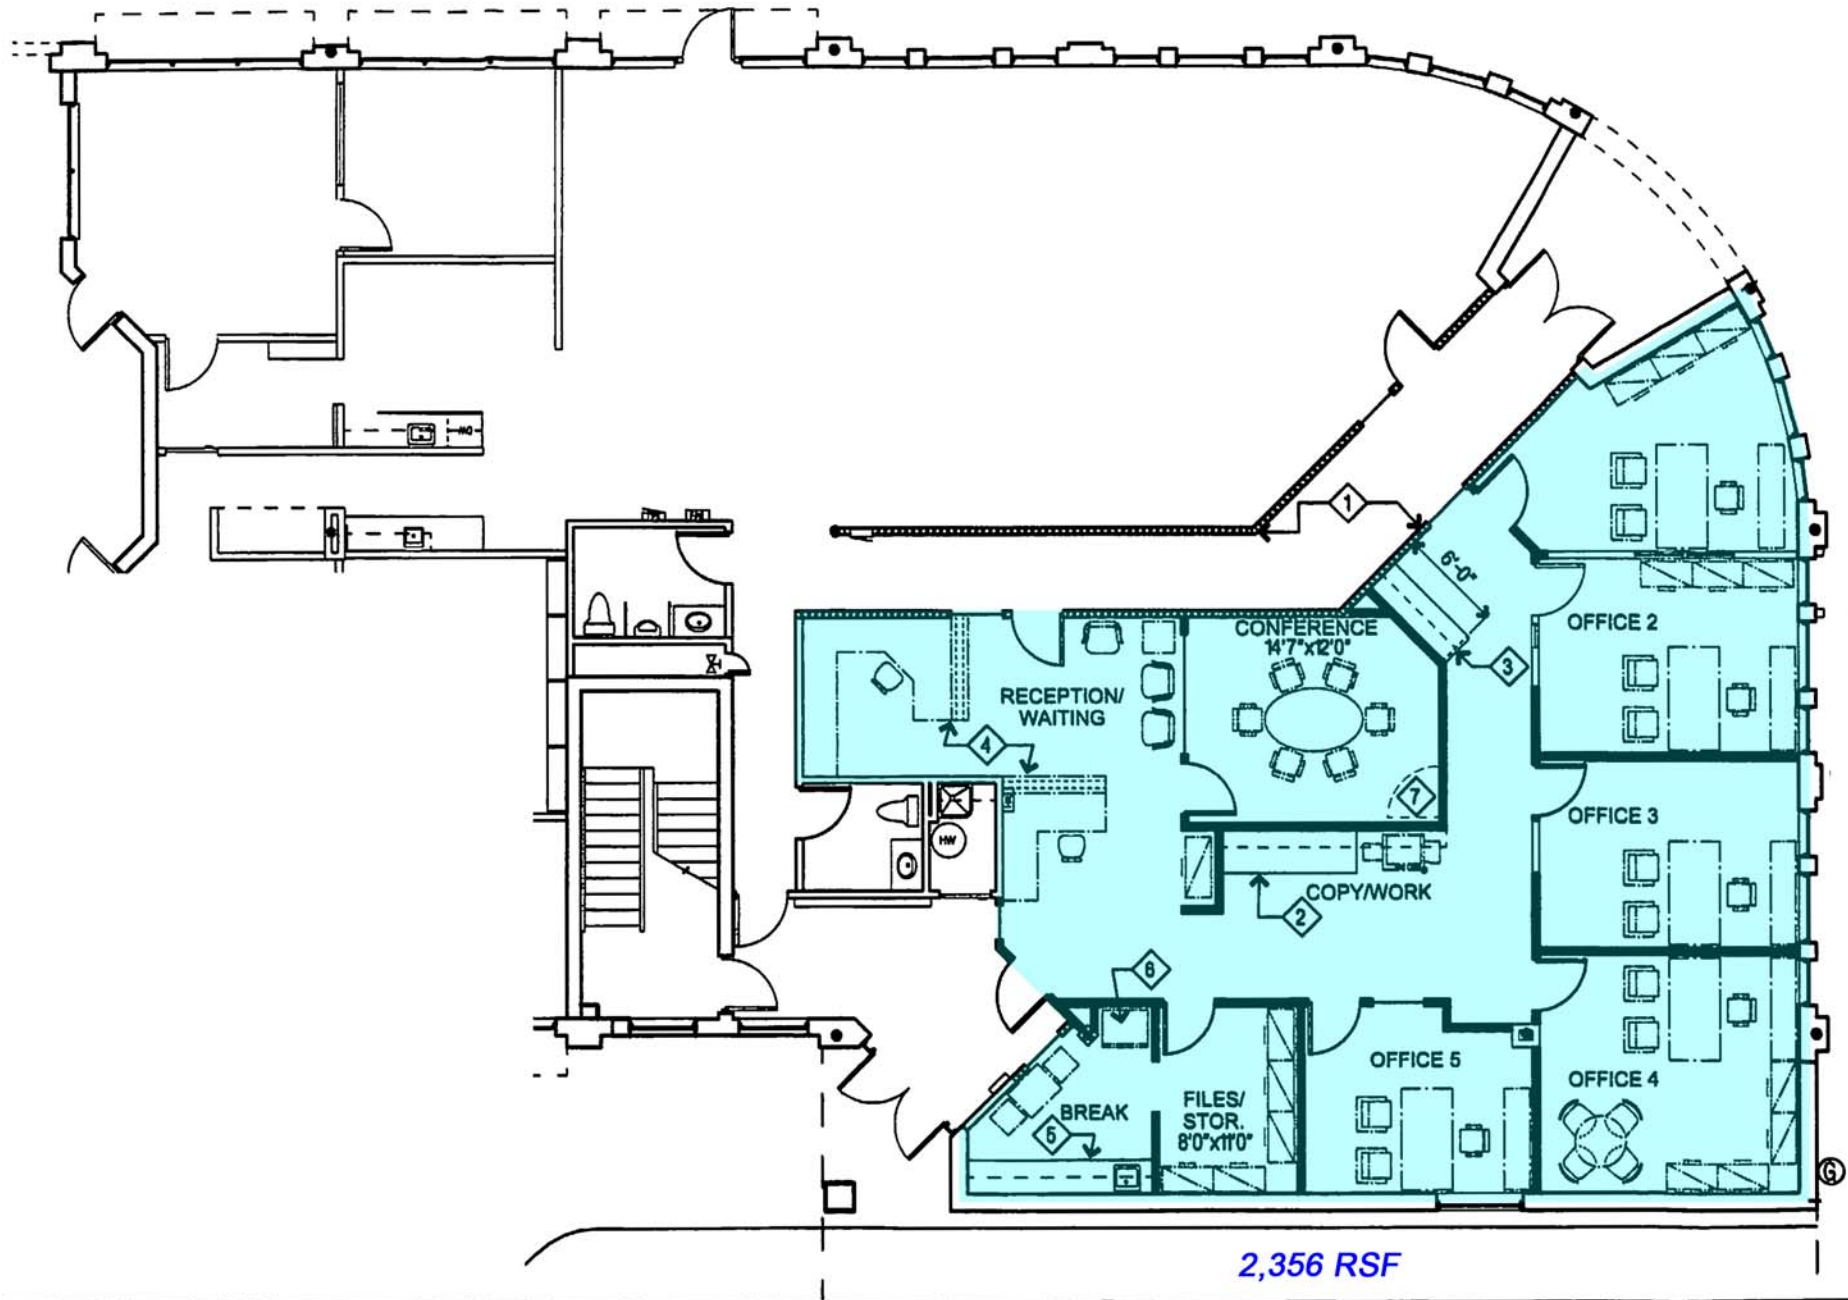


**PBV Architects, LLC**  
 12861 E. Cornell Ave ♦ Aurora, CO 80014  
 (P) 303.698.6789 ♦ paul@pbva.net ♦ (F) 303.484.7750

**AFFILIATED REAL ESTATE GROUP, LLC**  
 COMMERCIAL REAL ESTATE SERVICES

**SUITE 100 REMODEL**  
**SOUTH SIDE SUITES - OPTION 3**  
**THE EXCHANGE BUILDING**  
 19590 East Mainstreet Parker, CO.

0 2.5 5 10  
 SCALE: 3/32" = 1'-0"  
 DATE: 08.03.11

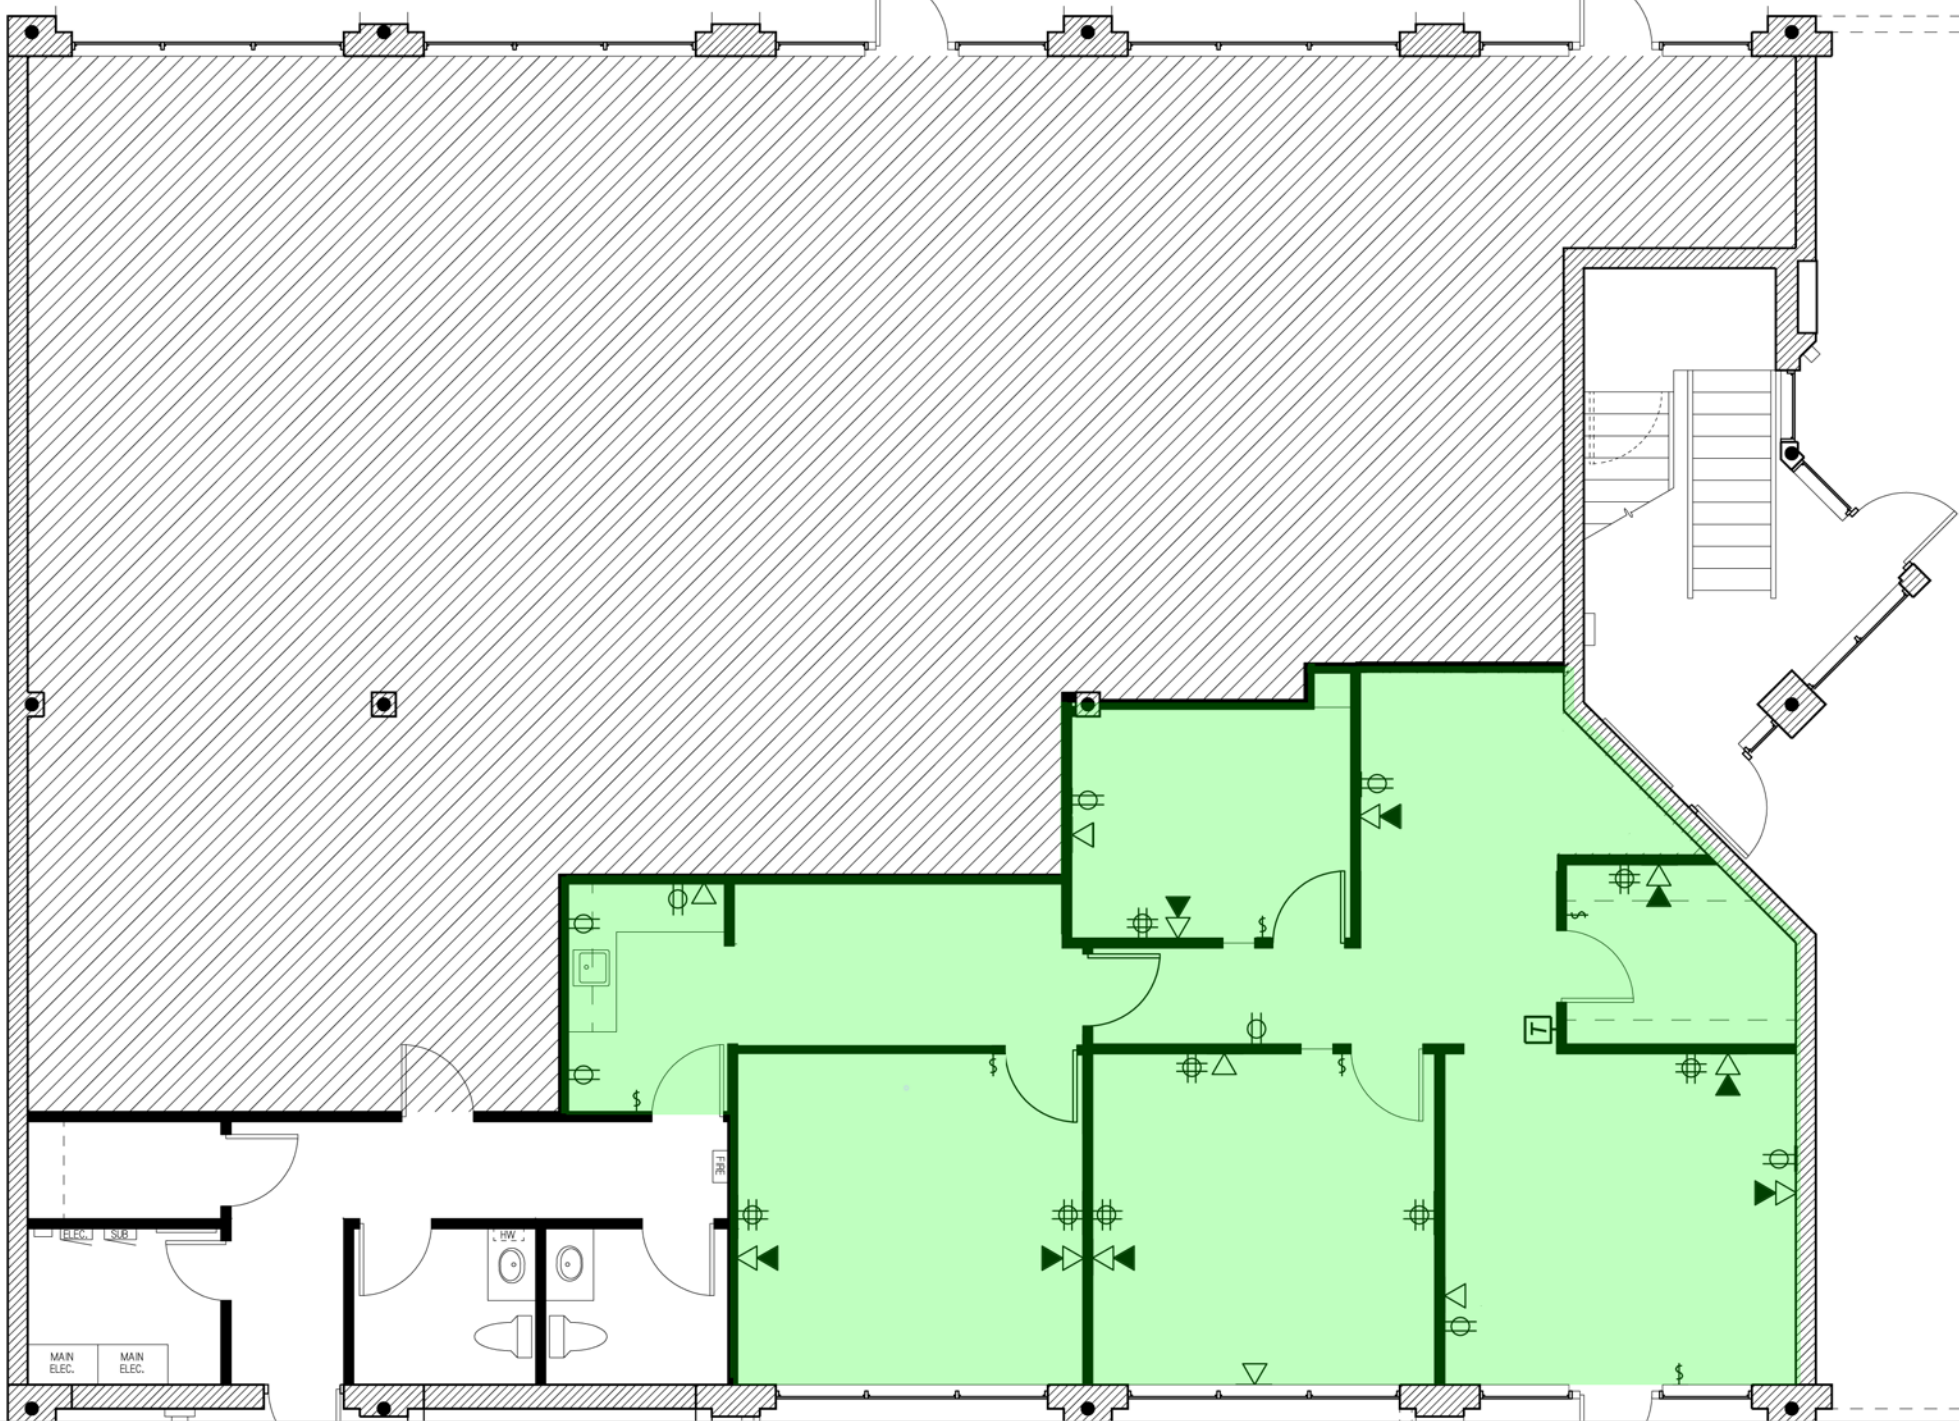



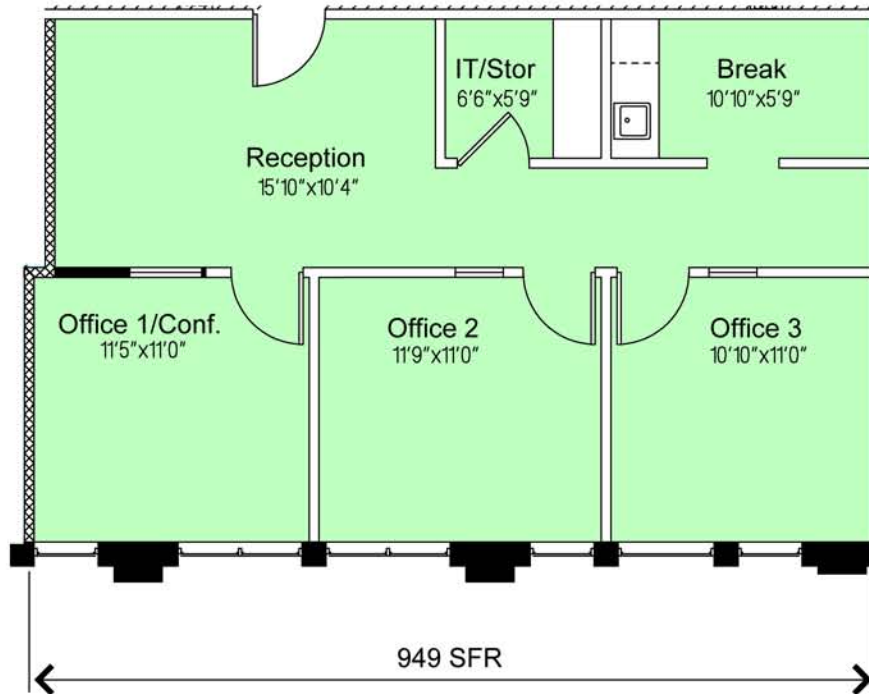



**PBV Architects, LLC**
  
 12361 E. Cornell Ave ♦ Aurora, CO 80014  
 (P) 303.699.6789 ♦ paul@pbva.net ♦ (F) 303.484.7750



**AFFILIATED REAL ESTATE GROUP, LLC**  
 COMMERCIAL REAL ESTATE SERVICES

**AS BUILT SUITE 110** *1,462 SqFt*  
**THE EXCHANGE BUILDING**  
 19590 East Mainstreet  
 Parker, Colorado

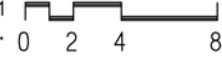DRAWN: 01.28.11  
 REVISED:  
 SHEET: AB-1.1A  
  
 SCALE: 1/8"=1'-0"  




SUITE 202

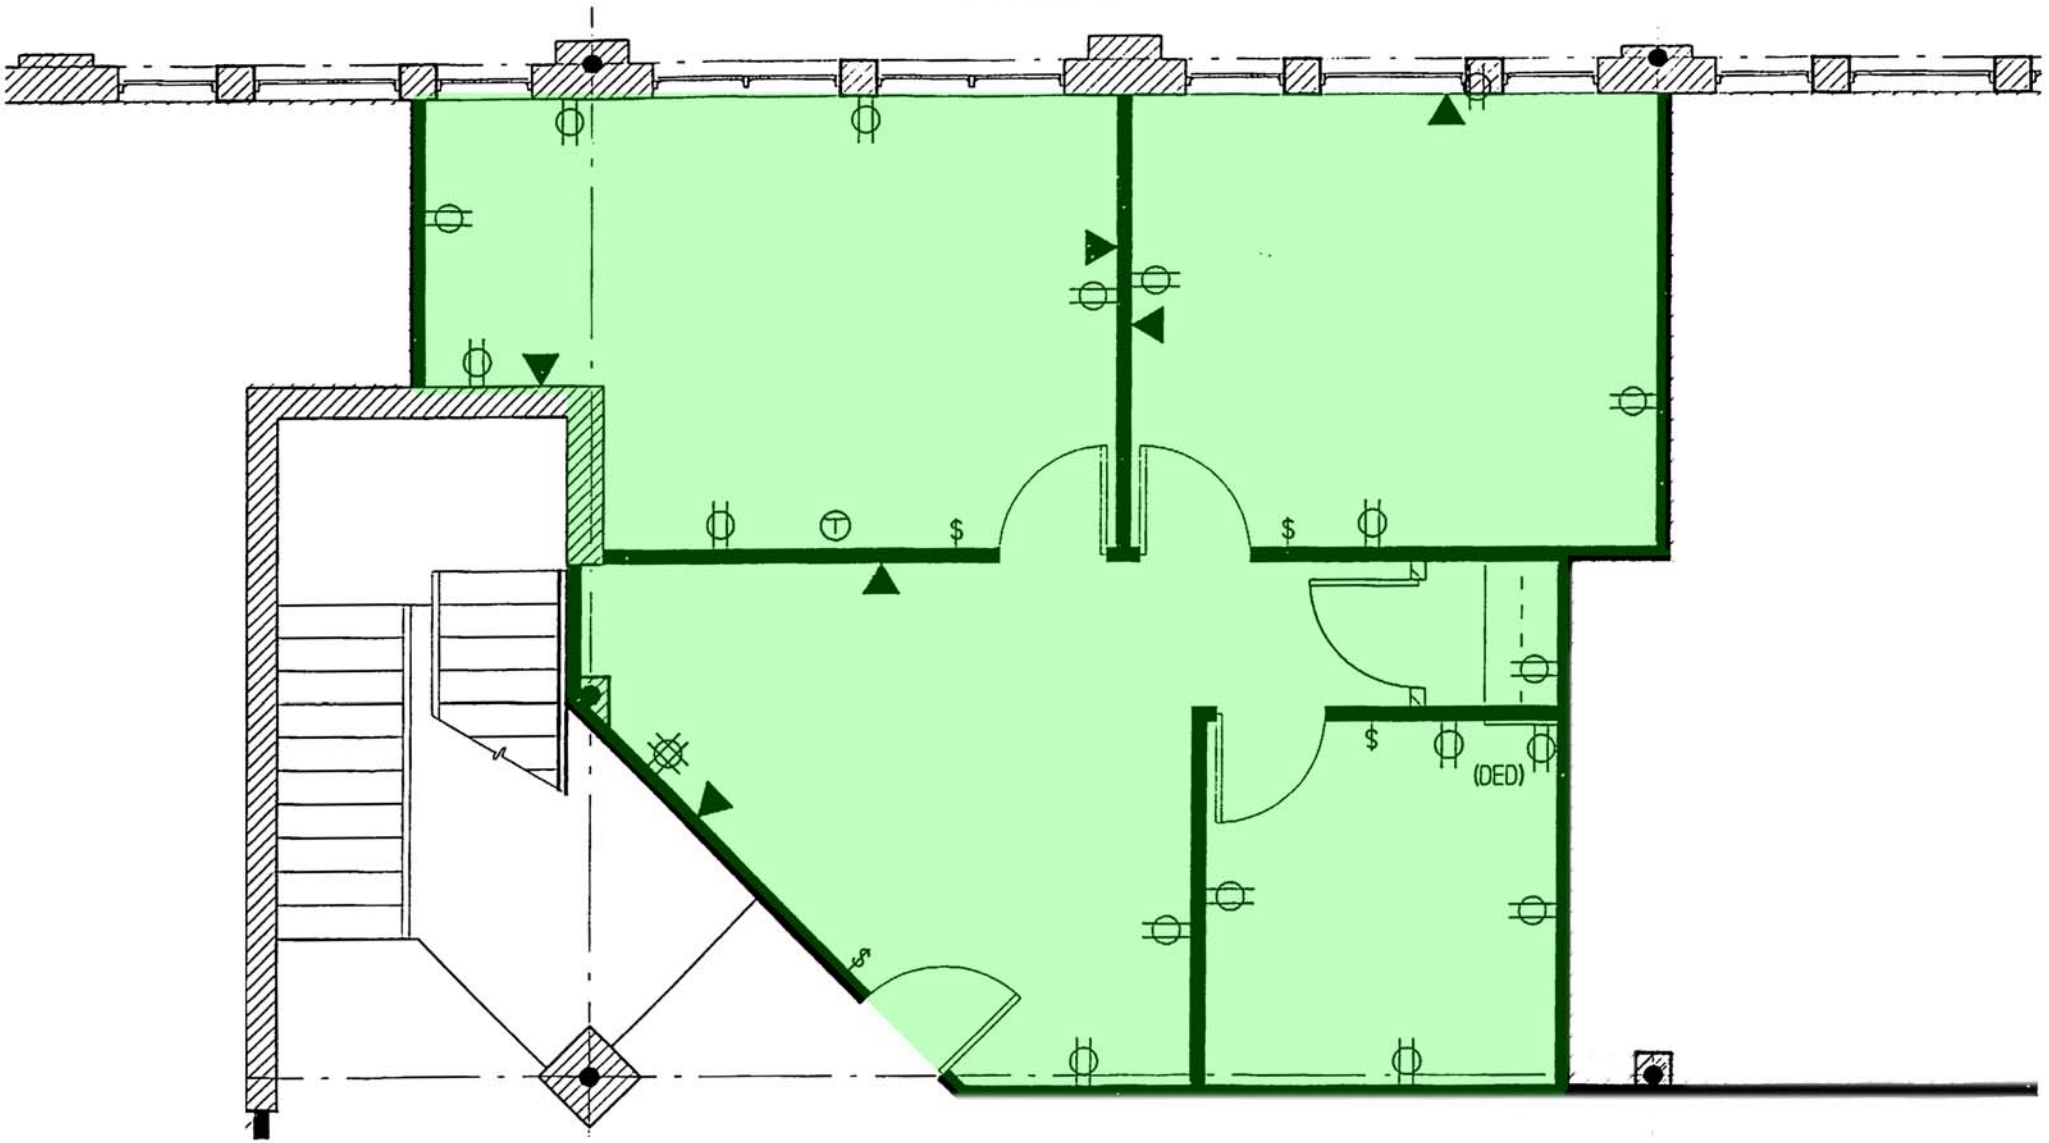

937 SqFt

Initial  
P.B.V.  
M.S.


PAUL B. VERNON,  
ARCHITECT  
6781 S. GARDNER CANYON  
AVENUE, COLORADO 80016  
PHONE 699-6789




AFFILIATED REAL ESTATE GROUP, LLC  
COMMERCIAL REAL ESTATE SERVICES

SUITE 202 AS BUILT PLAN  
THE EXCHANGE BUILDING  
19590 East Mainstreet  
Parker, Colorado

DRAWN: 9.21.01  
REVISED:  
SHEET: SK-1.1A  
SCALE: 3/16" = 1'-0"

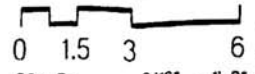

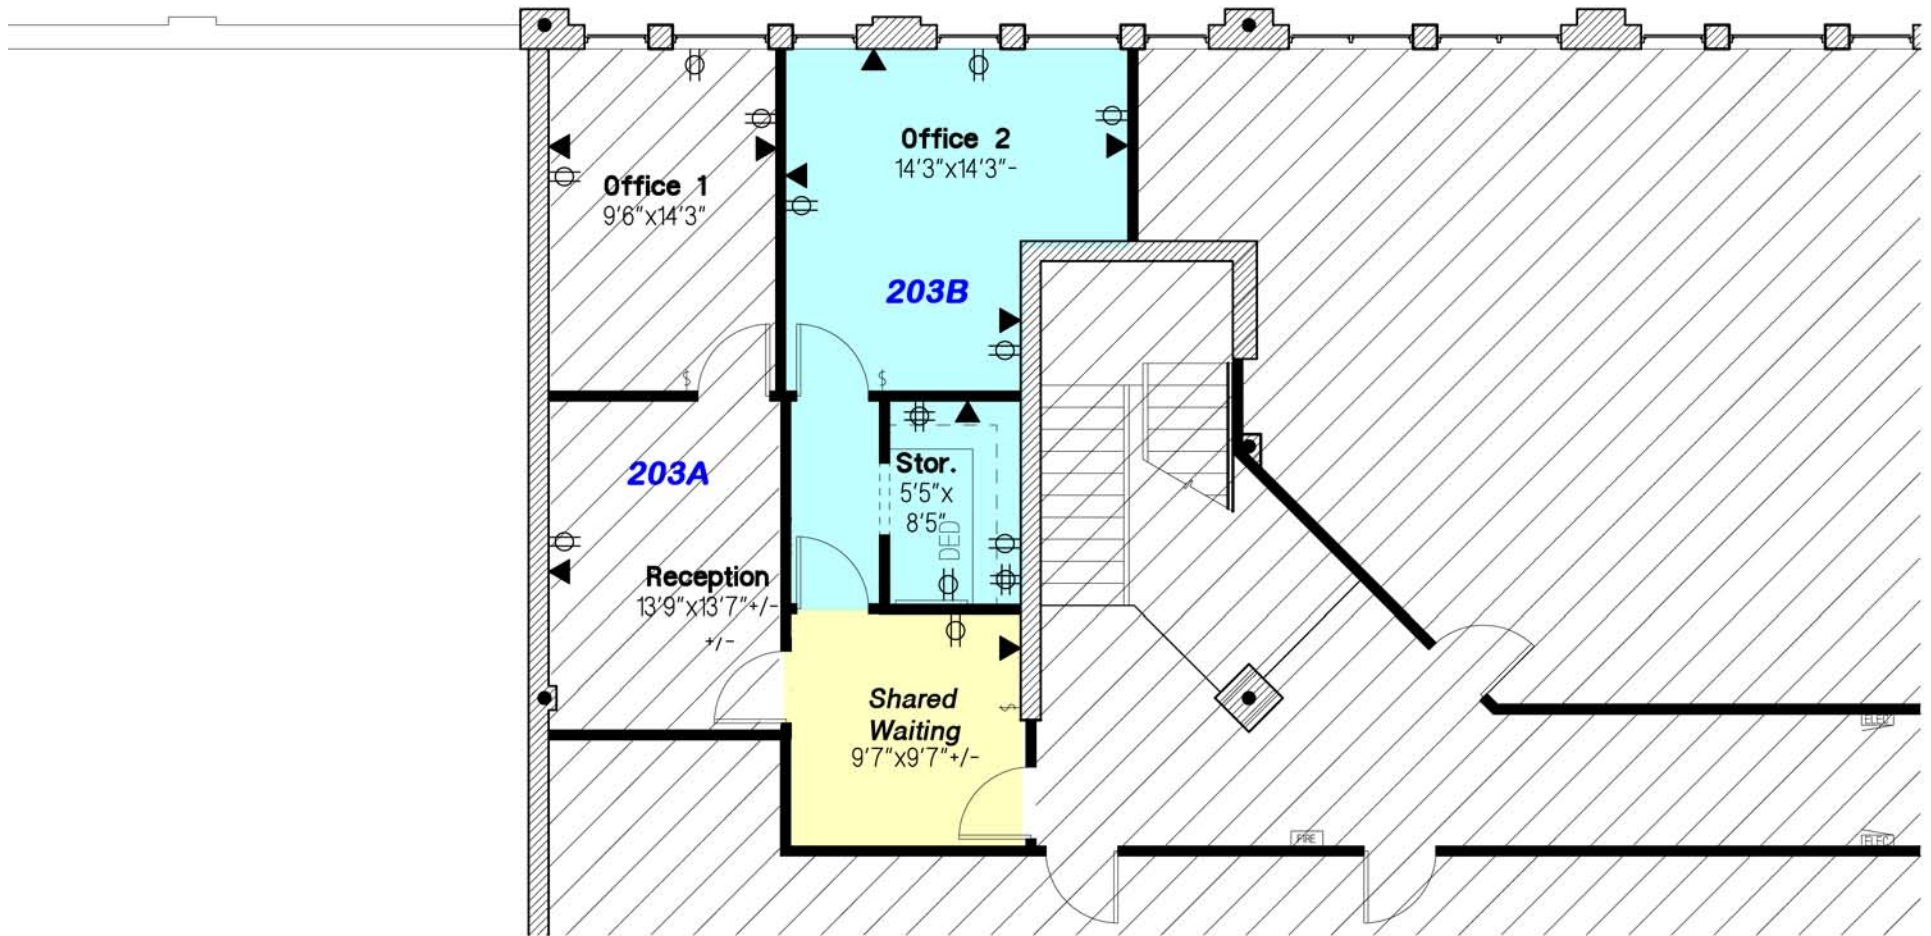

**Suite 203B = 413 Sq Ft**

**PAUL B. VERNON,  
ARCHITECT**

6781 S. Gibraltar Court  
Aurora, Colorado 80016  
(303) 699-6789



**AFFILIATED REAL ESTATE GROUP, LLC**

COMMERCIAL REAL ESTATE SERVICES

**SUITE 203  
FLOOR PLAN  
THE EXCHANGE BUILDING  
19590 East Mainstreet Parker, Colorado**

DRAWN:  
REVISED:

05.03.05



**SHEET: 203/204-A1.1A**

SCALE: 1/8" = 1'-0"

