


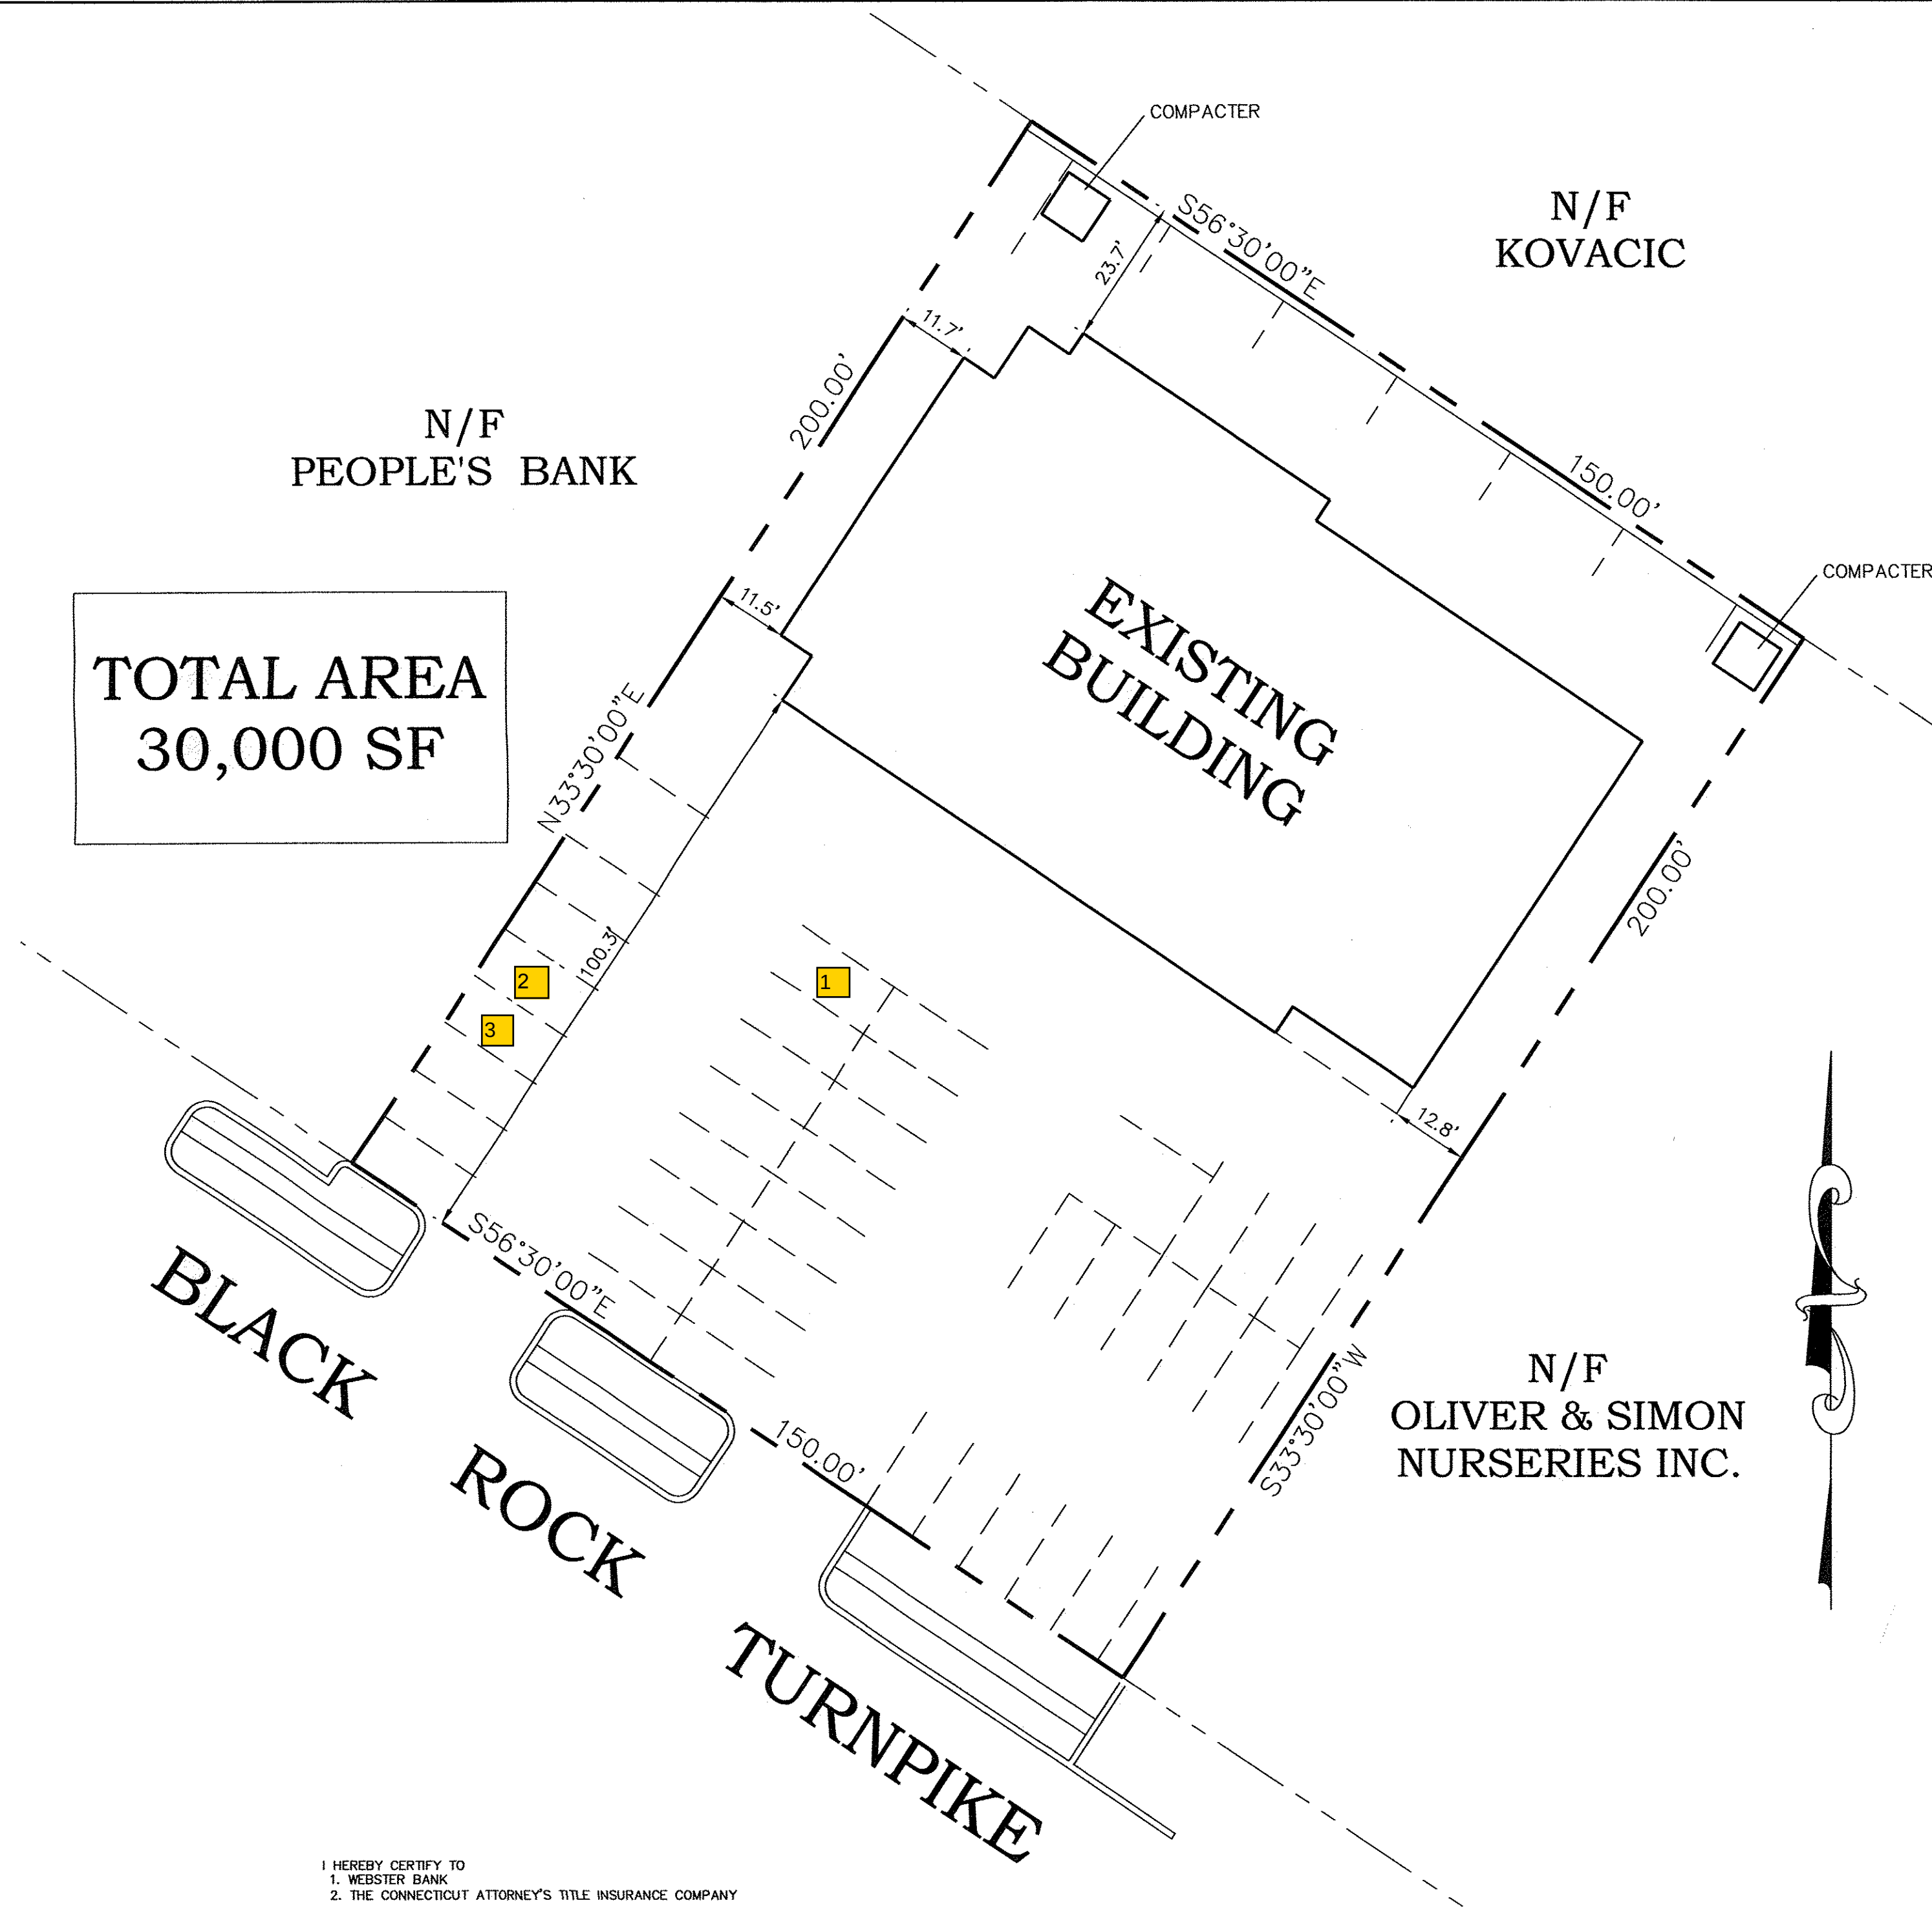

I HEREBY CERTIFY TO
1. WEBSTER BANK
2. THE CONNECTICUT ATTORNEY'S TITLE INSURANCE COMPANY

THIS SURVEY AND MAP HAS BEEN PREPARED IN ACCORDANCE WITH SECTIONS 20-300B-1 TO 20-300B-20 OF THE REGULATIONS OF CONNECTICUT STATE AGENCIES. IT IS A MAP BASED ON A DEPENDANT RESURVEY CONFORMING TO HORIZONTAL ACCURACY CLASS D TO THE BEST OF MY KNOWLEDGE AND BELIEF THIS MAP IS SUBSTANTIALLY CORRECT AS NOTED HEREON.

Fred D'Amico
FRED D'AMICO CONN. P.E., L.S. 10833

D'AMICO ASSOCIATES
SURVEYING & ENGINEERING CONSULTANTS
9 PARK ROAD
OXFORD, CONNECTICUT 06478
P: (203) 881-3184
F: (203) 881-0248
damicoassociates@sbcglobal.net

Job No.
474
Scale
1"=20'

Drn By
FAD
Date
2/15/2012

Project Name
ROBERT SANTANGELI
1910-1920 BLACK ROCK TURNPIKE
FAIRFIELD CONNECTICUT

Drawing Title
AS BUILT

No.	Date	REVISION DESCRIPTION
1.	8/12/2014	REVISE CERTIFICATION