


A1.1

SUITE 6 AS-BUILT

SCALE: 1/8" = 1'-0"

1,350 USF

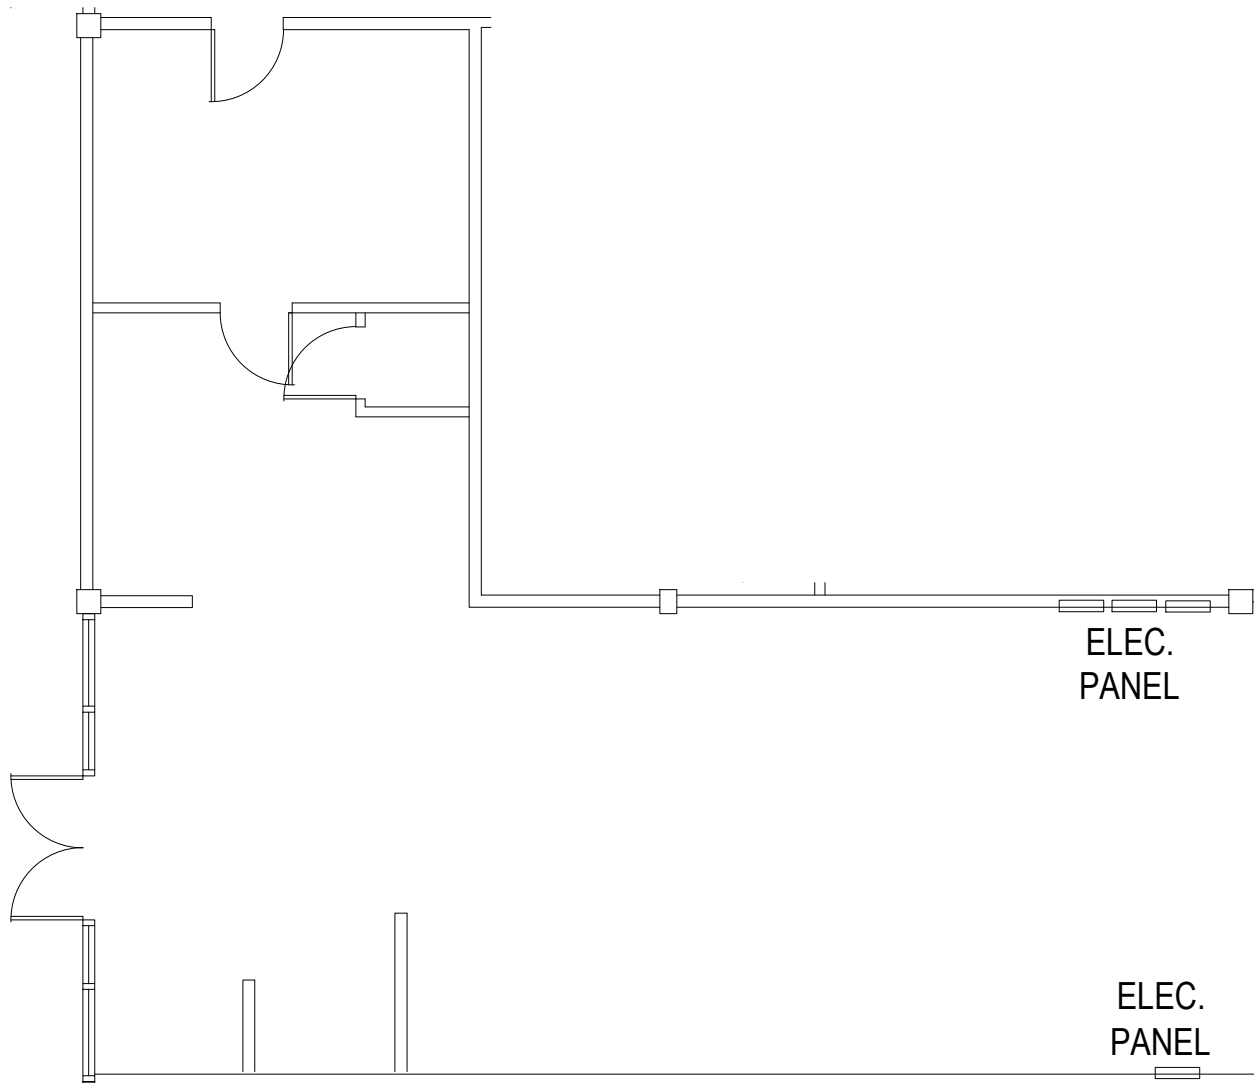

AS-BUILT FOR:
TOWN PLAZA
SUITE 6
5311 E MILL PLAIN BLVD
VANCOUVER, WA

DATE:	9.21.2016
FILE:	2016-24-00
JOB:	2016-24-01
DWN:	TK
CHK:	-

A1.1

[TKA] space planning/commercial renovation/
interior design/dental/medical

1327 SE Division St.
Portland Oregon 97202
ph: 503 236 0243
fx: 503 546 5668

TONIKING & ASSOCIATES