


ASSOCIATED CONDOMINIUM CORPORATION

NORTH ANDOVER, MA.

SCALE: 1/8" = 1'-0"

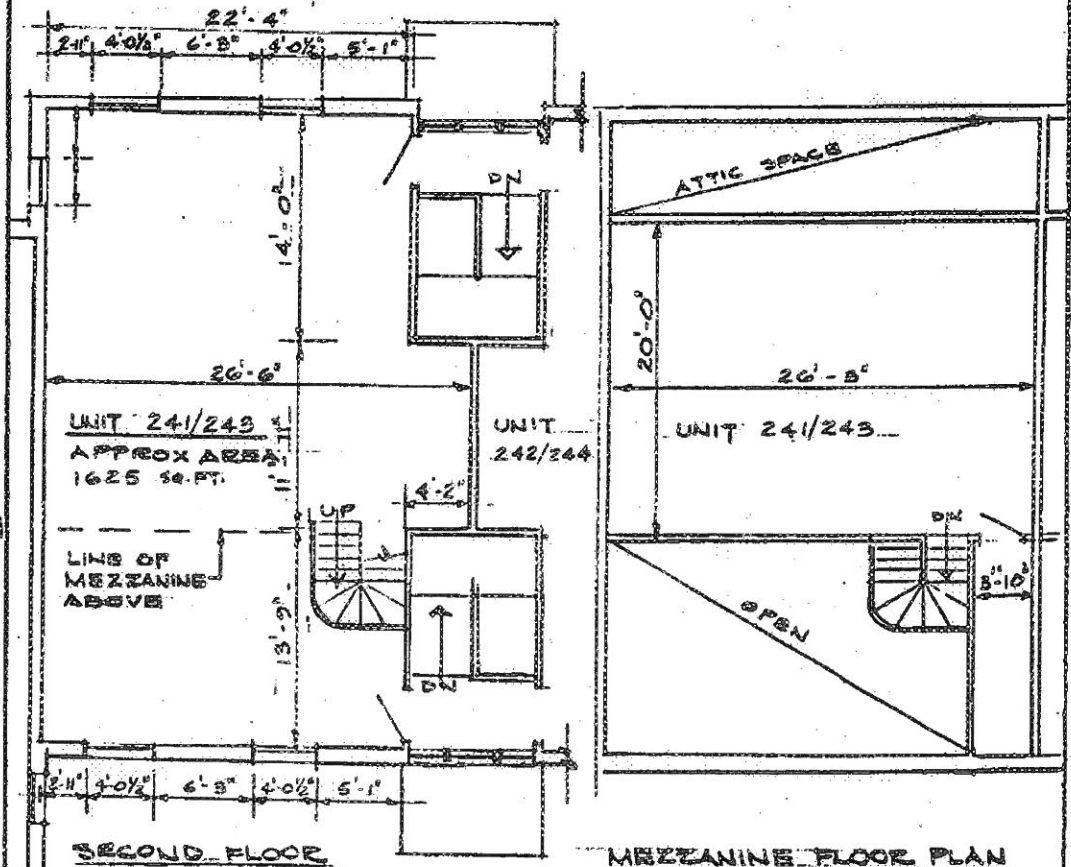

SECOND FLOOR BUILDING 853

MEZZANINE FLOOR PLAN

ALL DIMENSIONS ARE TO THE INTERIOR FACE OF STUDS.

UNIT 241/243



I CERTIFY THAT THIS PLAN FULLY & ACCURATELY  
 DEPICTS THE LAYOUT, LOCATION, UNIT DESIGNATION  
 OF IMMEDIATELY ADJOINING UNITS, DIMENSIONS,  
 APPROXIMATE AREA, ENTRANCES & IMMEDIATE  
 COMMON AREA TO WHICH IT HAS ACCESS AS BUILT.

*Thomas P. McClearn*  
 THOMAS P. MCCLEARN, AIA.  
 SEASON ARCHITECTURAL ASSOC. DATE: MARCH 26, 1987

Recorded Apr. 3, 1987 at 4:34PM #10160