


BUILDING KEY PLAN

**AVAILABLE
SUITE 240**
1,711 RSF

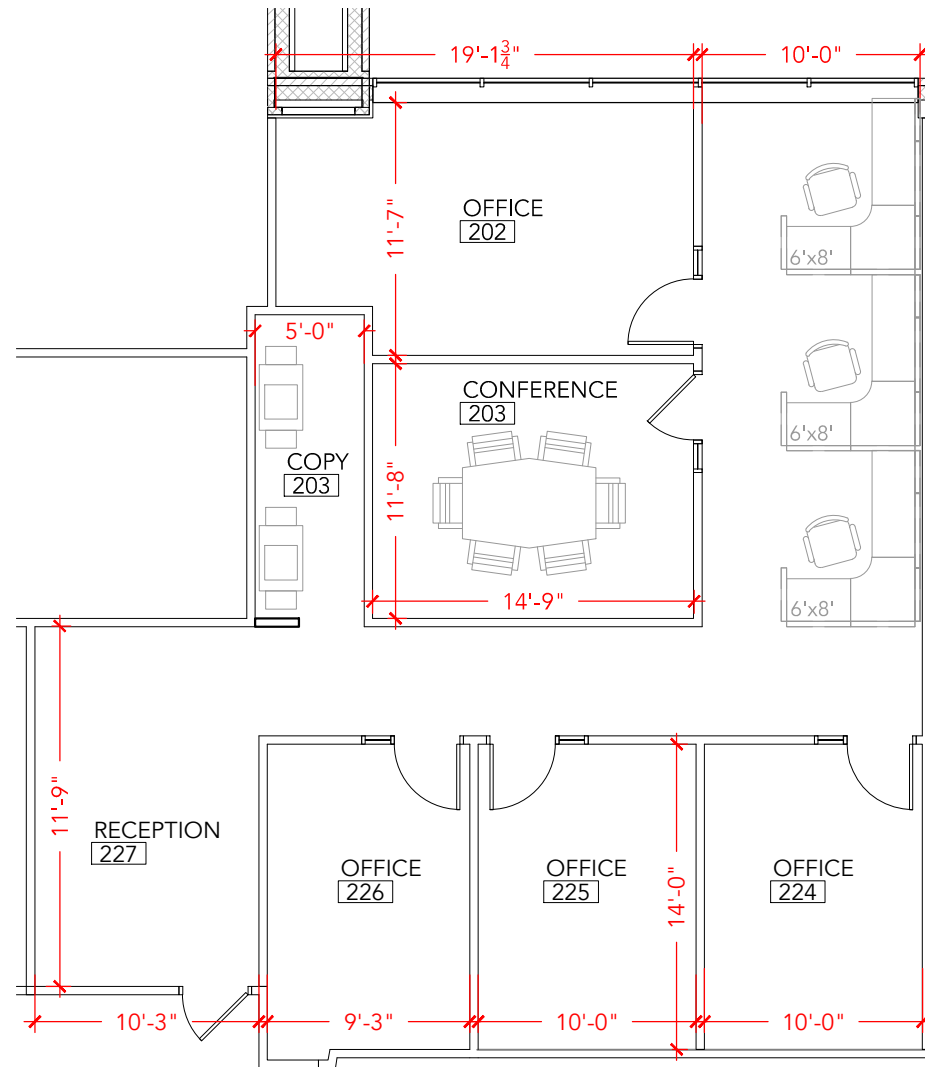

PLAN NOT TO SCALE - THIS IS NOT A CONSTRUCTION DOCUMENT

ASHBROOK
20116 ASHBROOK PLACE
ASHBURN, VA 20147
SUITE 240

ASBUILT

DATE :
ASBUILT DRAWN BY :
DRAWING # :



2066 LORD BALTIMORE DRIVE BALTIMORE, MD 21244
PHONE 410-298-2600 FAX: 410-298-9644
www.MerrittProperties.com