


LEASEE:
1639 11TH STREET, LLC
1639 - 11TH STREET
SUITE 220
SANTA MONICA, CAL.
90404

E.D.D.G. INC.
EL BAYAR DESIGN &
DEVELOPMENT GROUP INC.
22834 BRENFORD STREET
WOODLAND HILLS, CA. 91364
PHONE: (310) 503-1295

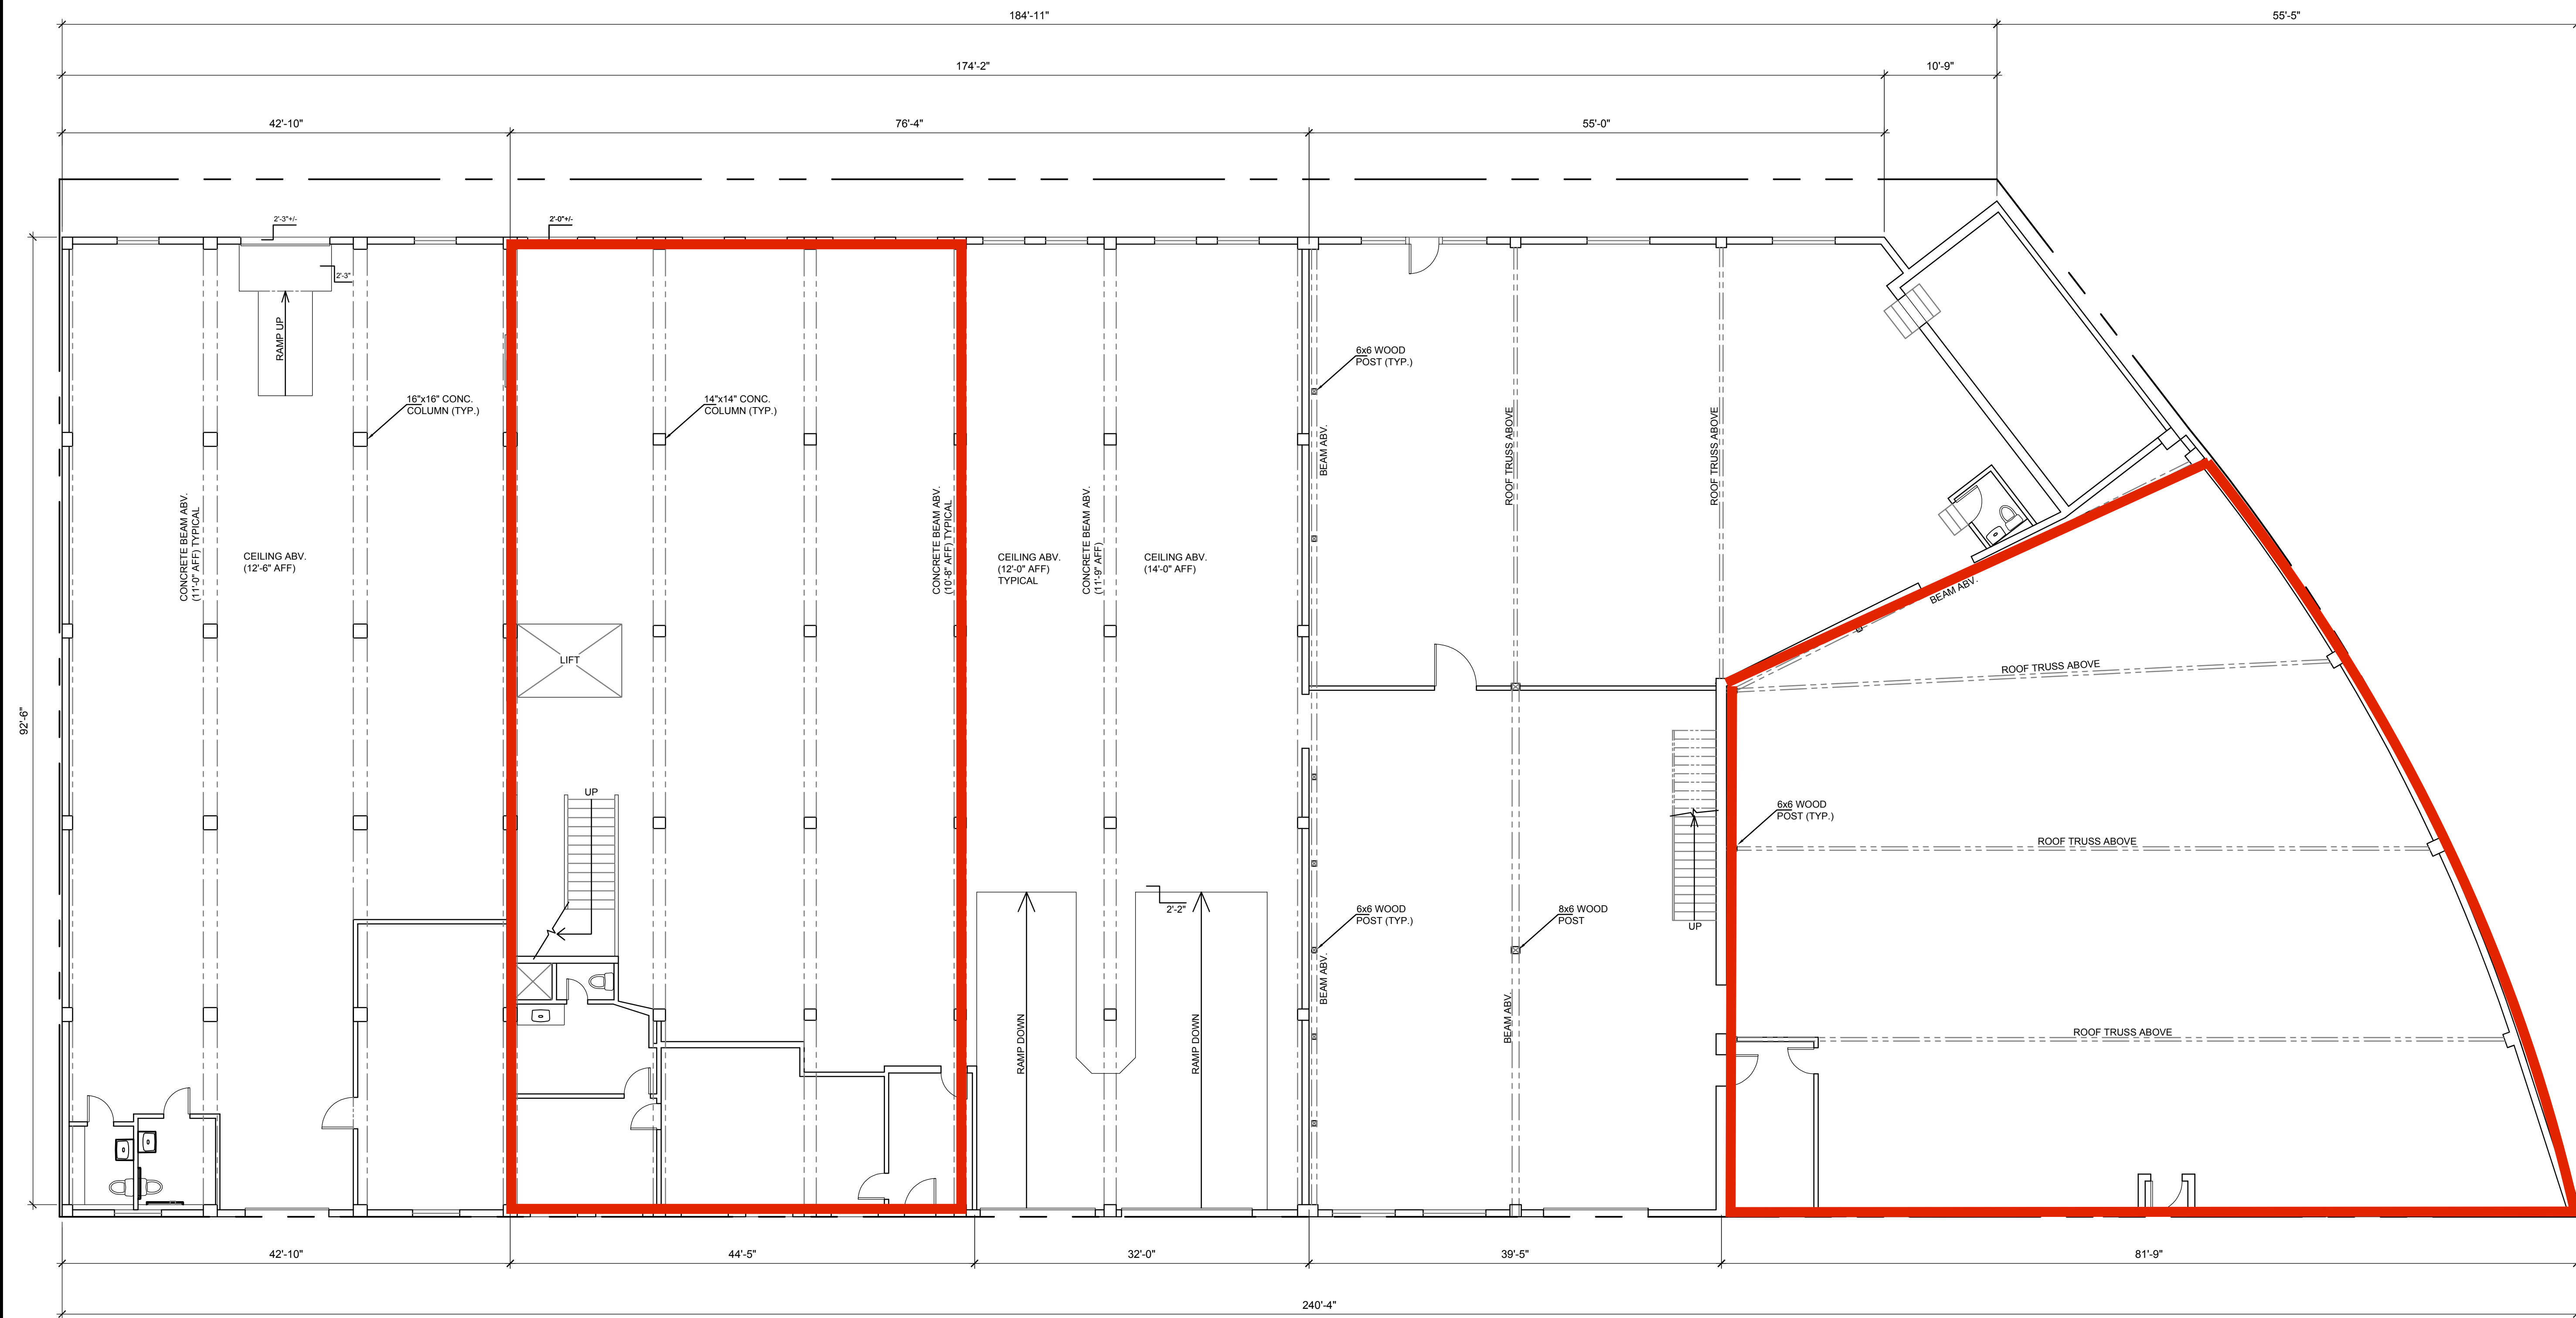

1325 - 1329
PALMETTO STREET

AS-BUILT PLAN

FIRST FLOOR PLAN

1/8" = 1'-0"



PALMETTO STREET

R (TYP.)

PROJECT

REVISIONS

PLOTTED DATE

SHEET TITLE

GRID FILE

SCALE

PROJECT NUMBER

DRAWN BY

SLB

SHEET NUMBER

1/15/17 A - 1