


15 Spinning Wheel

15 Spinning Wheel Road
Hinsdale, Illinois 60521

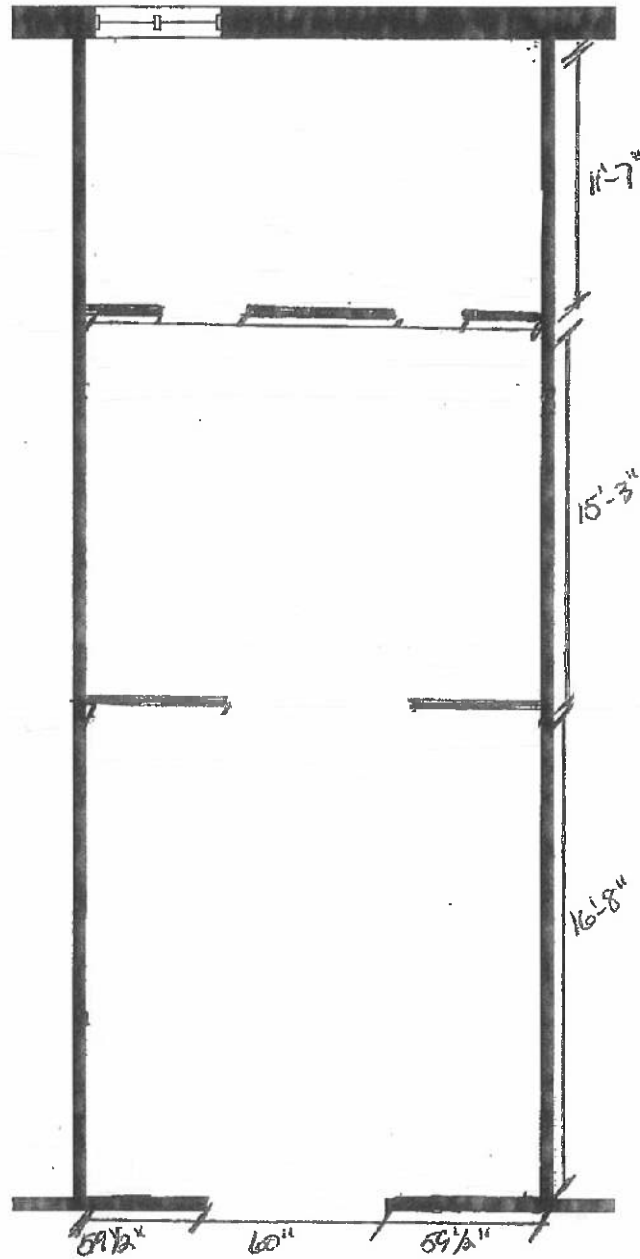

Suite 316 - As-Built Conditions

654 Rentable Square Feet

Scale:

N.T.S.

01_316_18

