


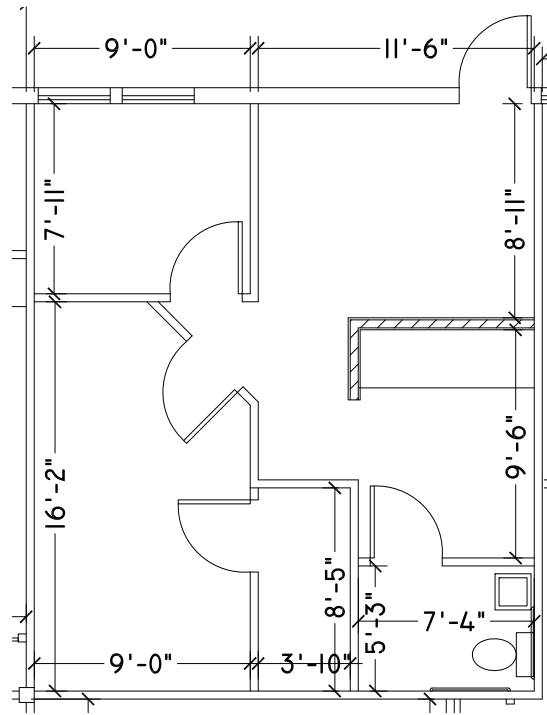

AS-BUILT

EASTPOINT OFFICE PARK
1001 NORTHPOINT BLVD.
STE. 508
BALTIMORE, MD
481 SQ.FT.

SCALE: 1/8" = 1'-0"
DATE: 4/11/08
REVISED:



Hill Management Services, Inc.
9640 Deereco Road
Timonium, Maryland 21093
(410) 666-1000
www.hillmgt.com