


DISCLAIMER:
The accuracy of all information on this floor plan is deemed reliable but not guaranteed and should be personally verified through personal inspections or with the appropriate professionals. All dimensions are approximate.

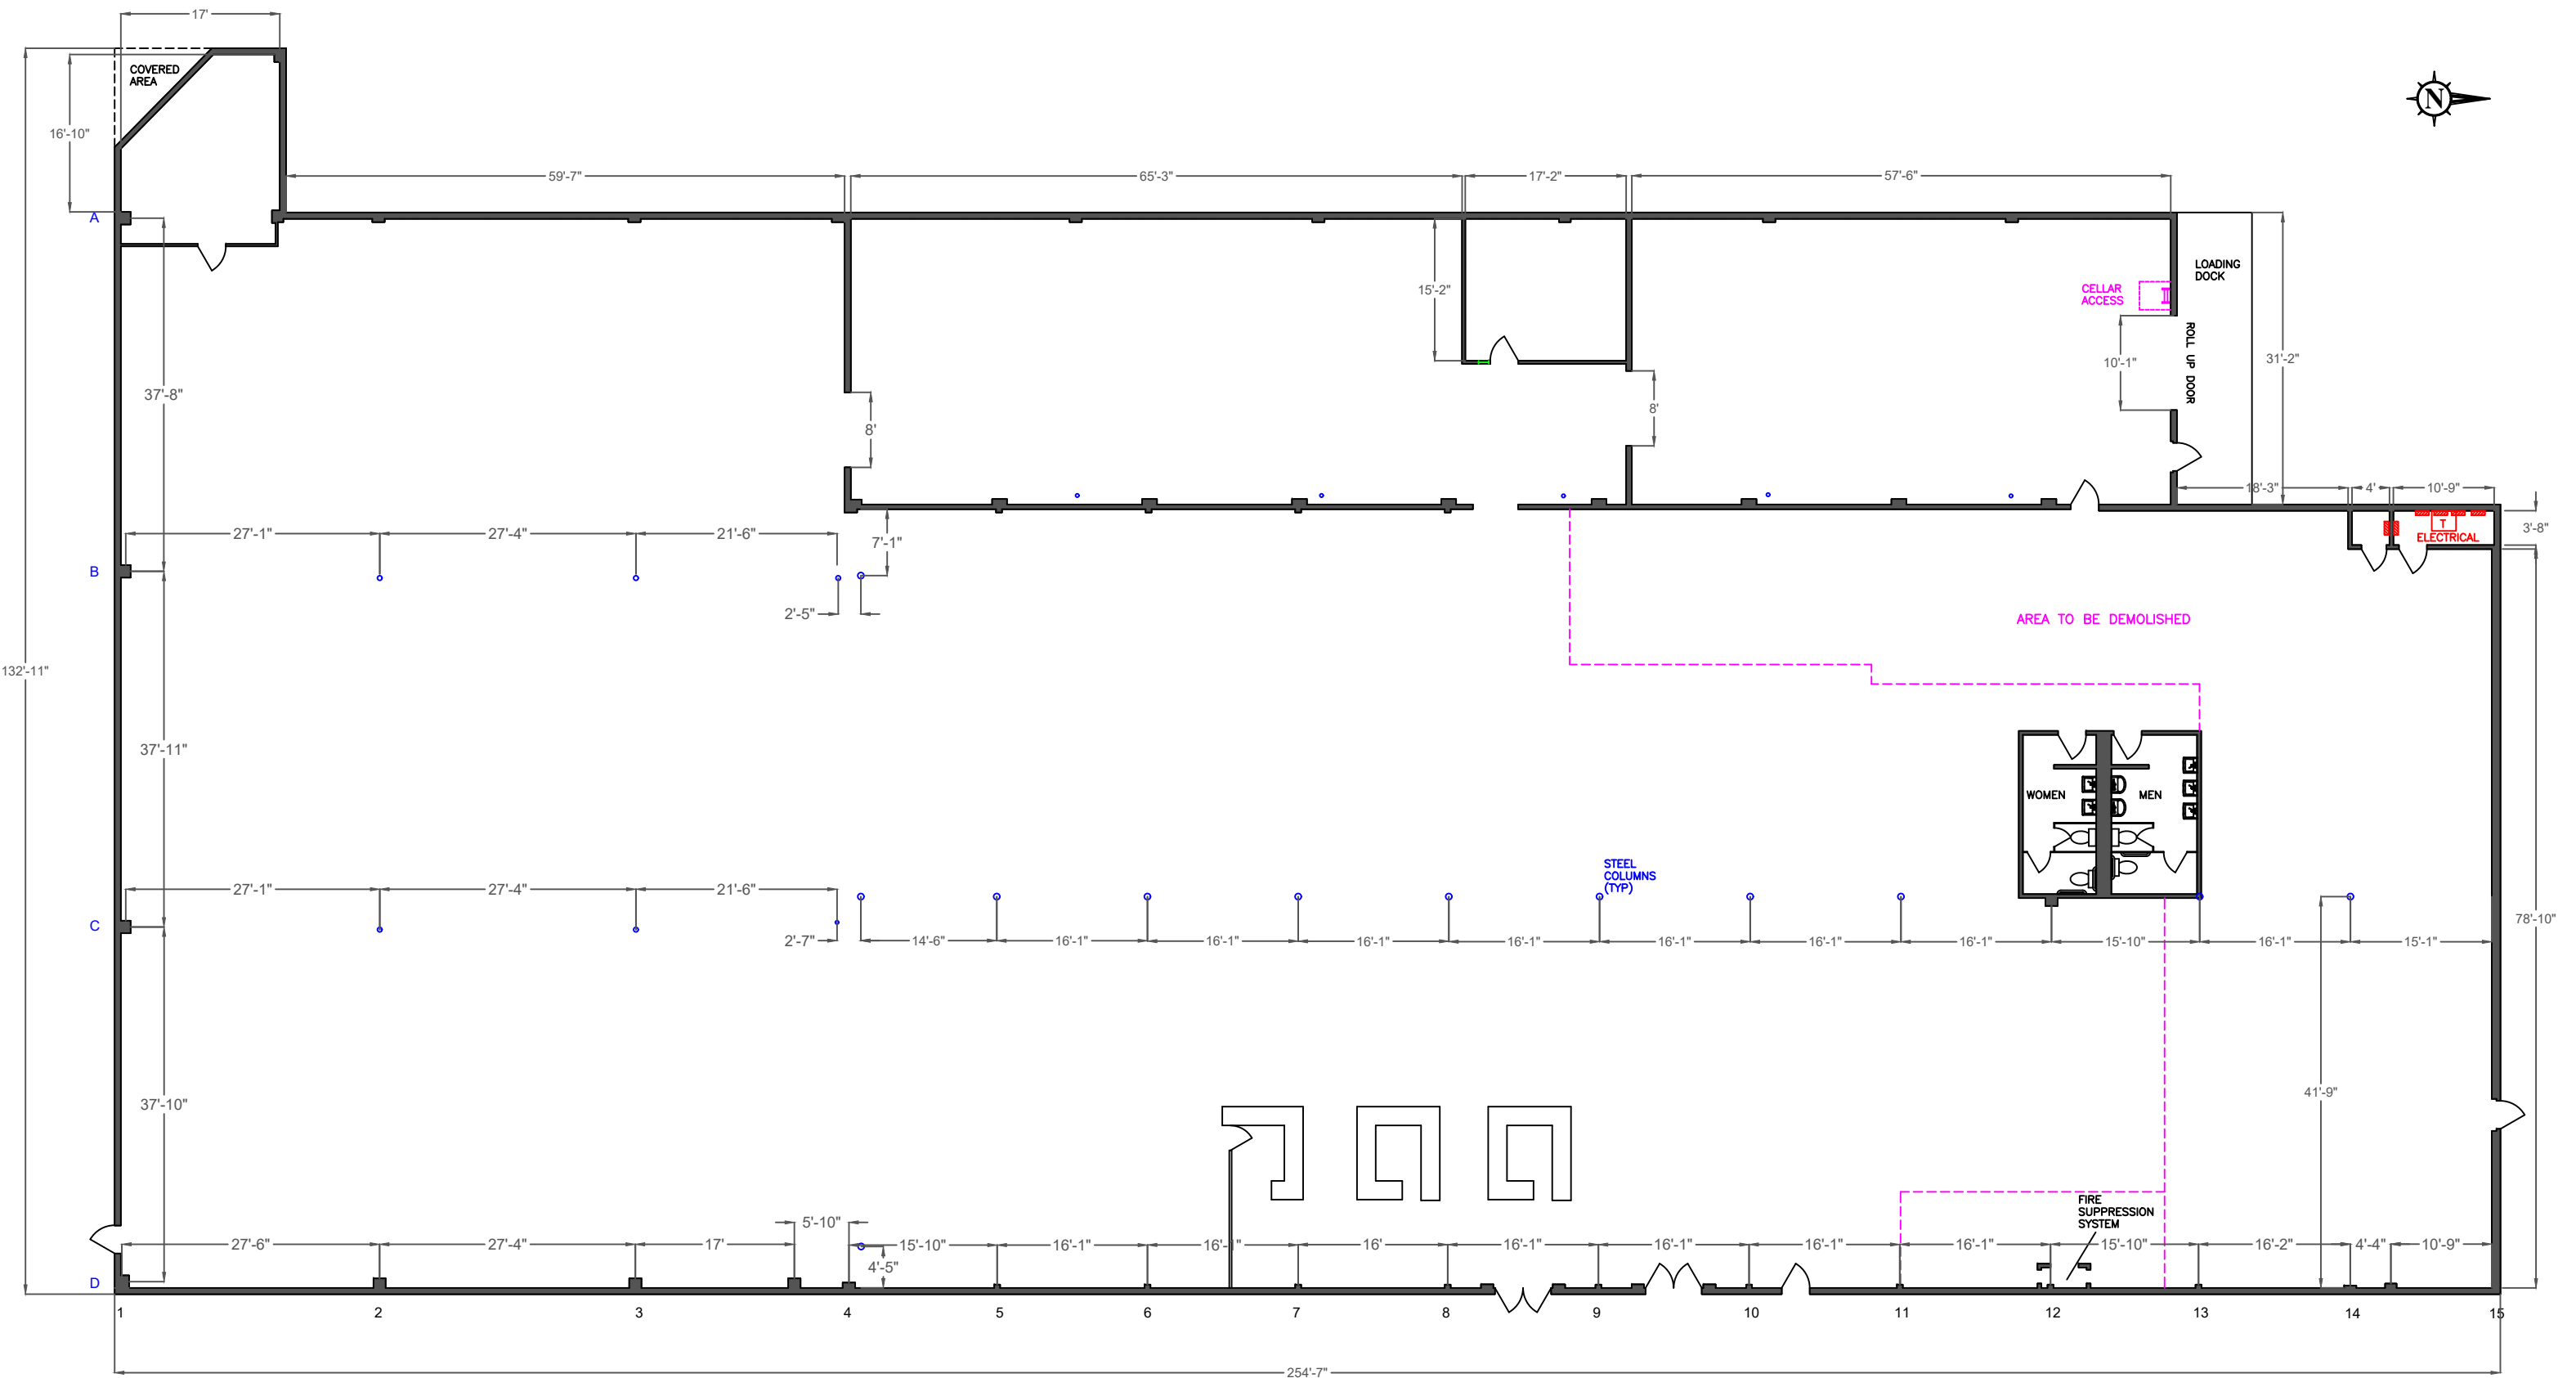

132'-11"


A

B

C

D

1 2 3 4 5 6 7 8 9 10 11 12 13 14 15

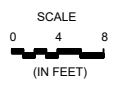

713-705-6812 CELL / edreyes7@yahoo.com

ALL DIMENSIONS APPROX.

LEGAL DESCRIPTION: TR 15 BLK 49 ABST 87 S M WILLIAMS	LOCATION: 2600 COMMERCE STREET HOUSTON, TEXAS 77003 DRAWING NO: 001 DATE: 05/14/2024
	APPROX. SQ. FT. = 28,562