SUITE 201

3033-3047 CARLING AVENUE, OTTAWA, ON
(AS-BUILT FLOOR PLAN)

10 FEET
3.05 METRES
0
1.59

DRAWING ORIENTATION

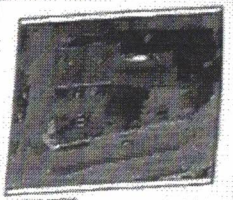

AERIAL VIEW

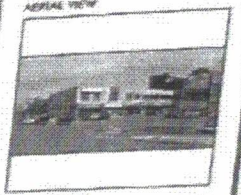

EXTERIOR VIEW

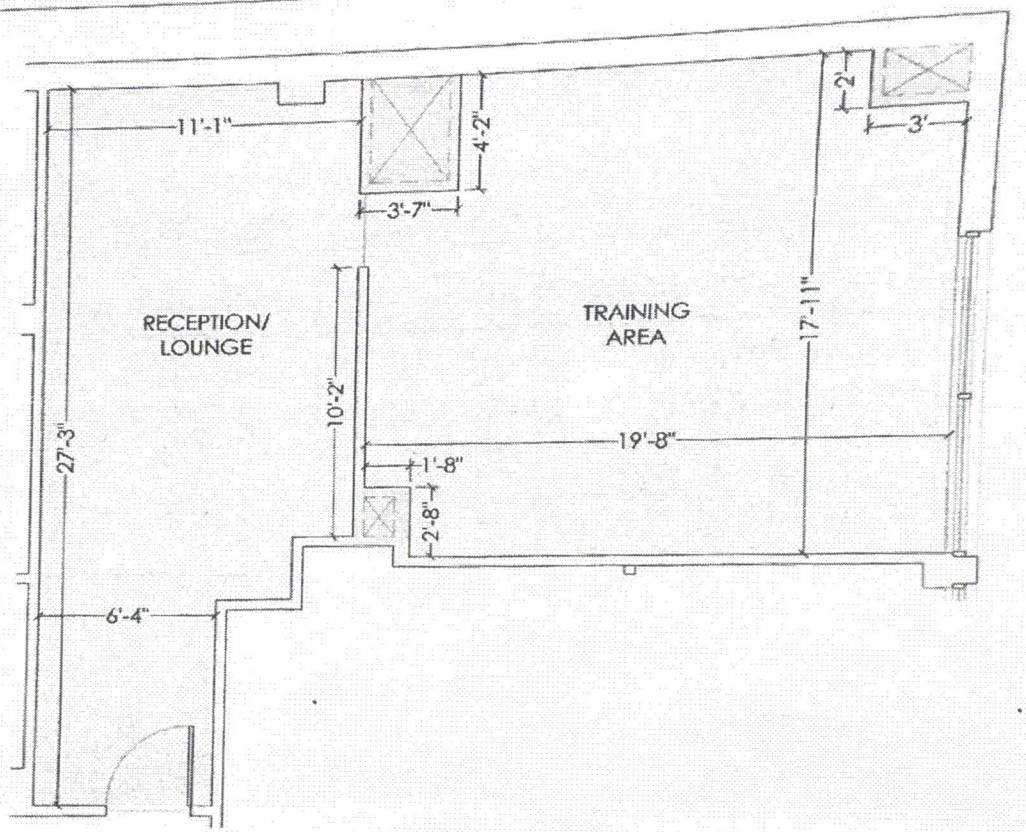

LEGEND:
- EXISTING WALLS
- ELEC ELECTRICAL
- EP ELECTRICAL PANEL
- HWT HOT WATER TANK
- T TRANSFORMER
- TEL TELECOMMUNICATIONS

SHADING LEGEND:
- MAJOR VERTICAL PENETRATION
- TENANT AREA 1
- TENANT AREA 2
- TENANT AREA 3
- TENANT AREA 4
- BUILDING COMMON AREA
- FLOOR COMMON AREA

PREPARED FOR: Acadia Realty Inc.
ADDRESS: 3033-3047 Carling Ave.,
Ottawa, ON
DATE: September 12, 2016
REVISION: n/a
PROJECT NUMBER: 300108
DRAWING SCALE: 1:1" = 1'-0" - Scaled Size

NOTE: SOME AREAS WERE NOT ACCESSIBLE TO MEASUREMENT

PREPARED BY: ECHOSQGROUP.COM

ECHO SQ GROUP