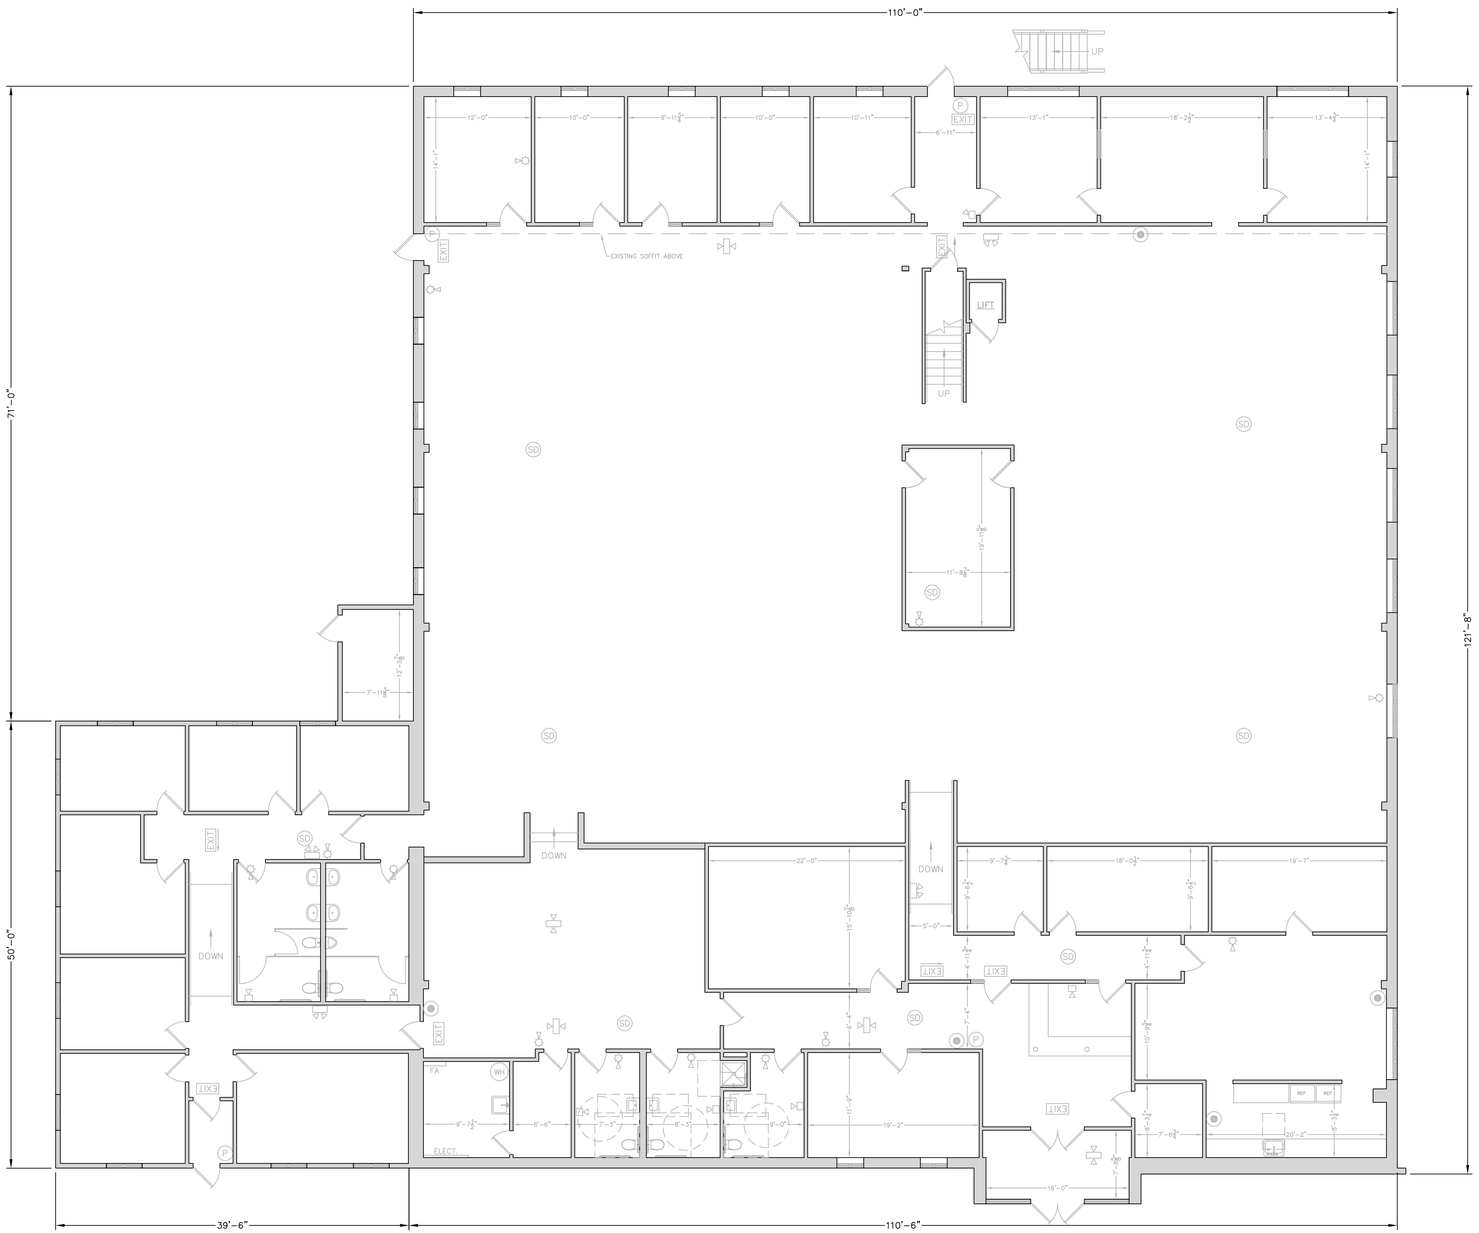

EXISTING FIRST FLOOR PLAN
SCALE 1/8" = 1'-0"

ENGINEERING
E.S.COFFIN
SURVEYING
© 2008
E.S. COFFIN ENGINEERING & SURVEYING, INC.
432 Cony Road P.O. Box 4687 Augusta, Maine 04330
Ph. (207) 623-9475 Fax (207) 623-0016 Toll Free 1-800-244-9475

NO.	REVISIONS	DATE

SHEET TITLE: **EXISTING FIRST FLOOR PLAN**

SCALE: 1/8"=1'-0"

DRAWN BY: JPK
CHECKED BY: BEM

DATE: NOVEMBER 9, 2012

CLIENT & PROJECT: **J&R ASSOCIATES**
268 WHITTEN ROAD AS-BUILT

LOCATION: 268 WHITTEN ROAD

TOWN: HALLOWELL COUNTY: KENNEBEC STATE: MAINE

PROJ. NO. 2012-031

A-1