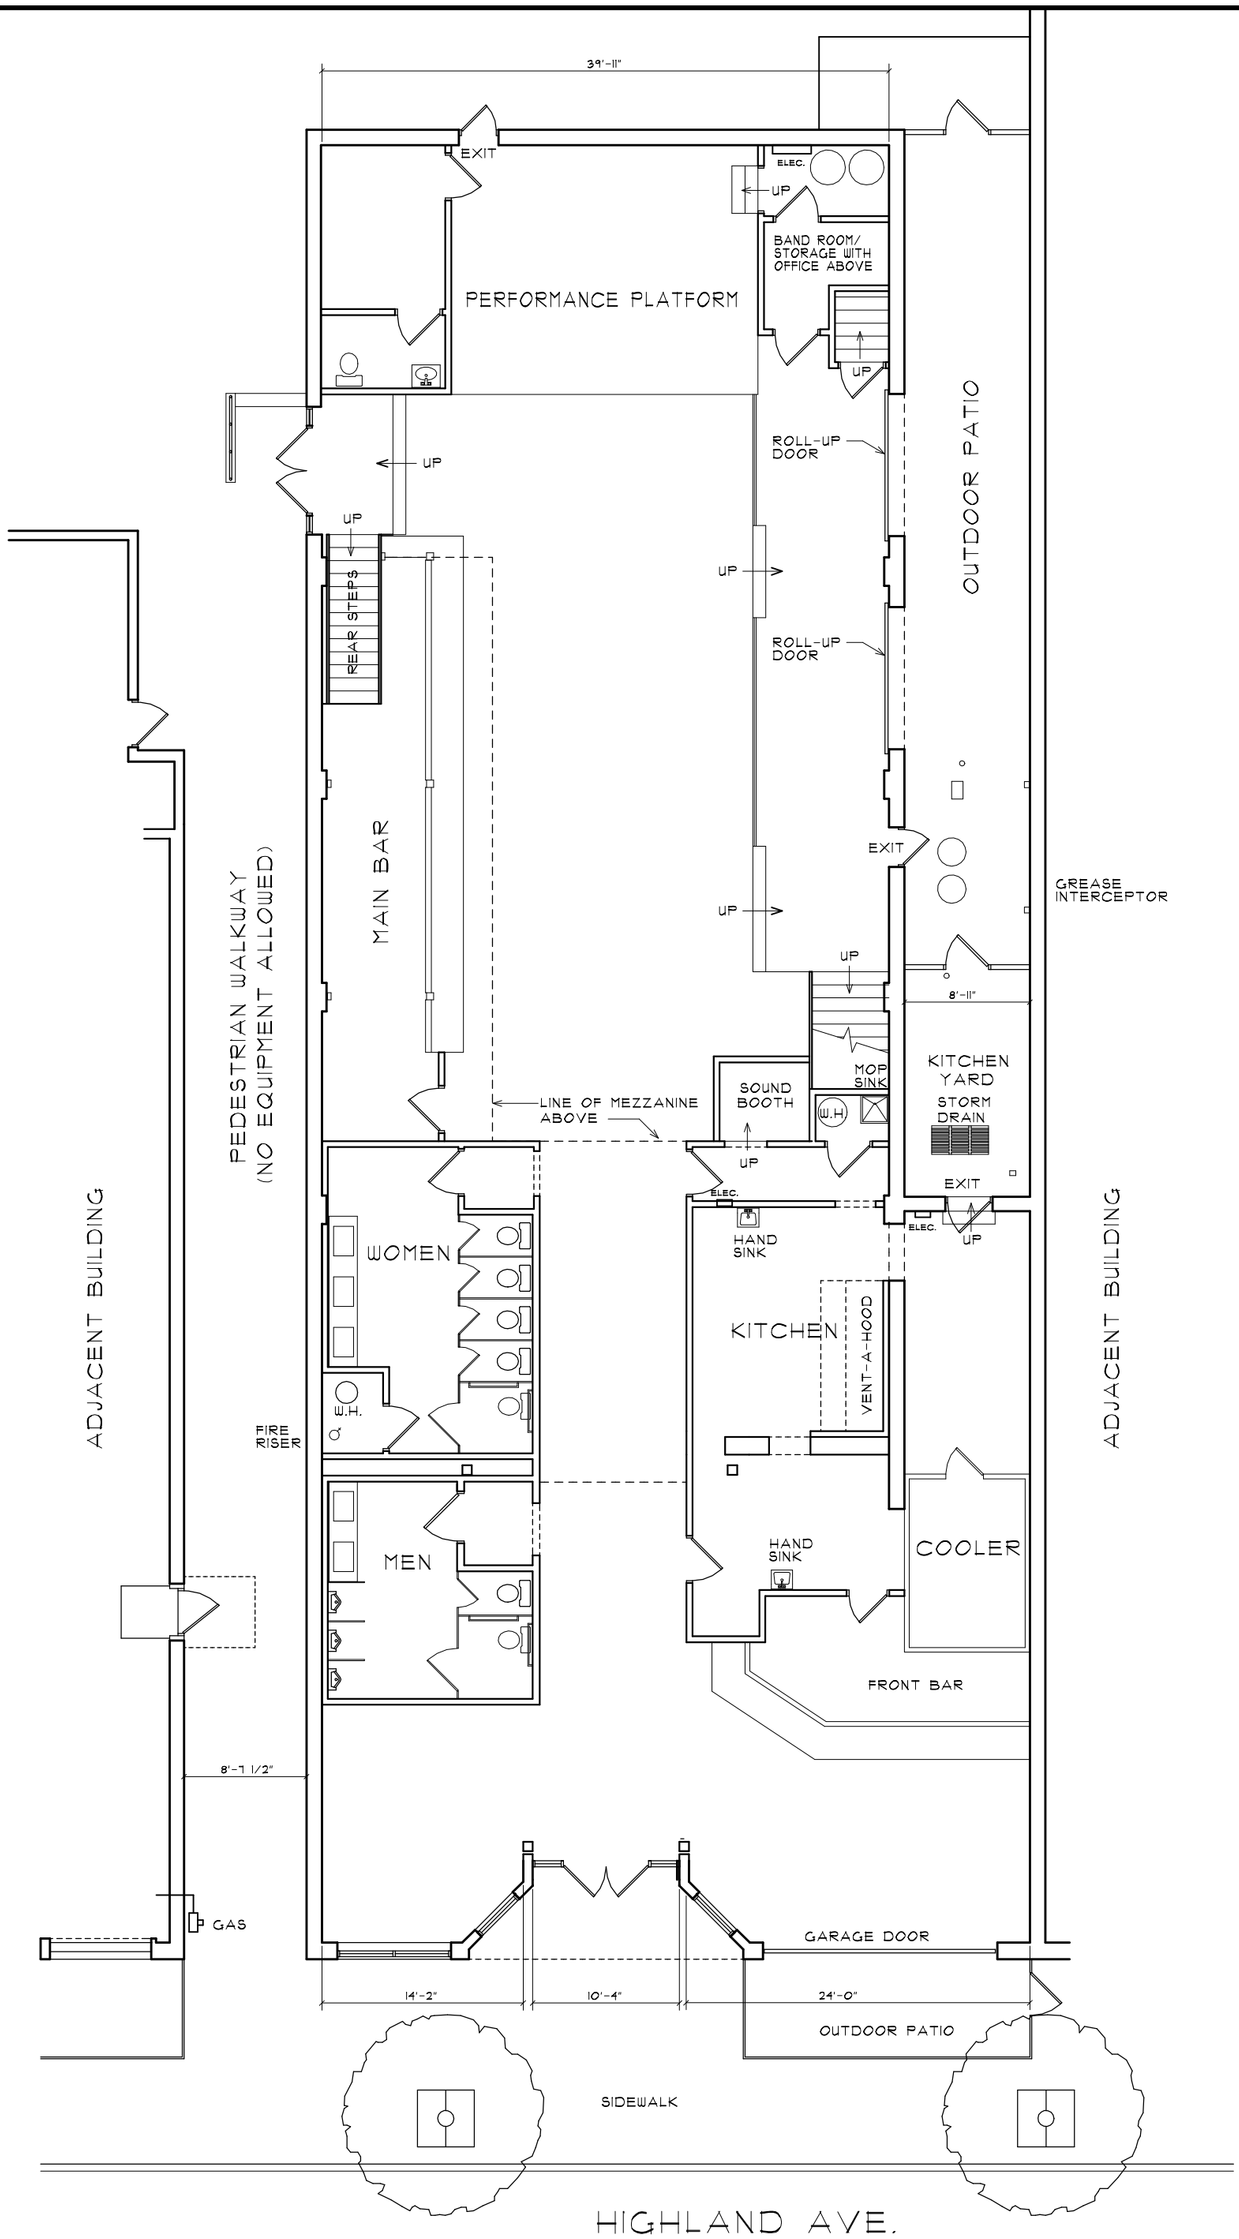

AS-BUILT 1ST FLOOR PLAN

5,952 S.F.

HIGHLAND STRIP 535 HIGHLAND ST. MEMPHIS, TN			LPI MEMPHIS 5264 POPLAR AVENUE MEMPHIS, TN 38119
SCALE	DATE	VERSION	
3/32"=1'-0"	2/16/20		