revised floor plan
reviewed and accepted
this _____day of September,2010

Dillon Courtyard Real Estate,LLC

By:_____

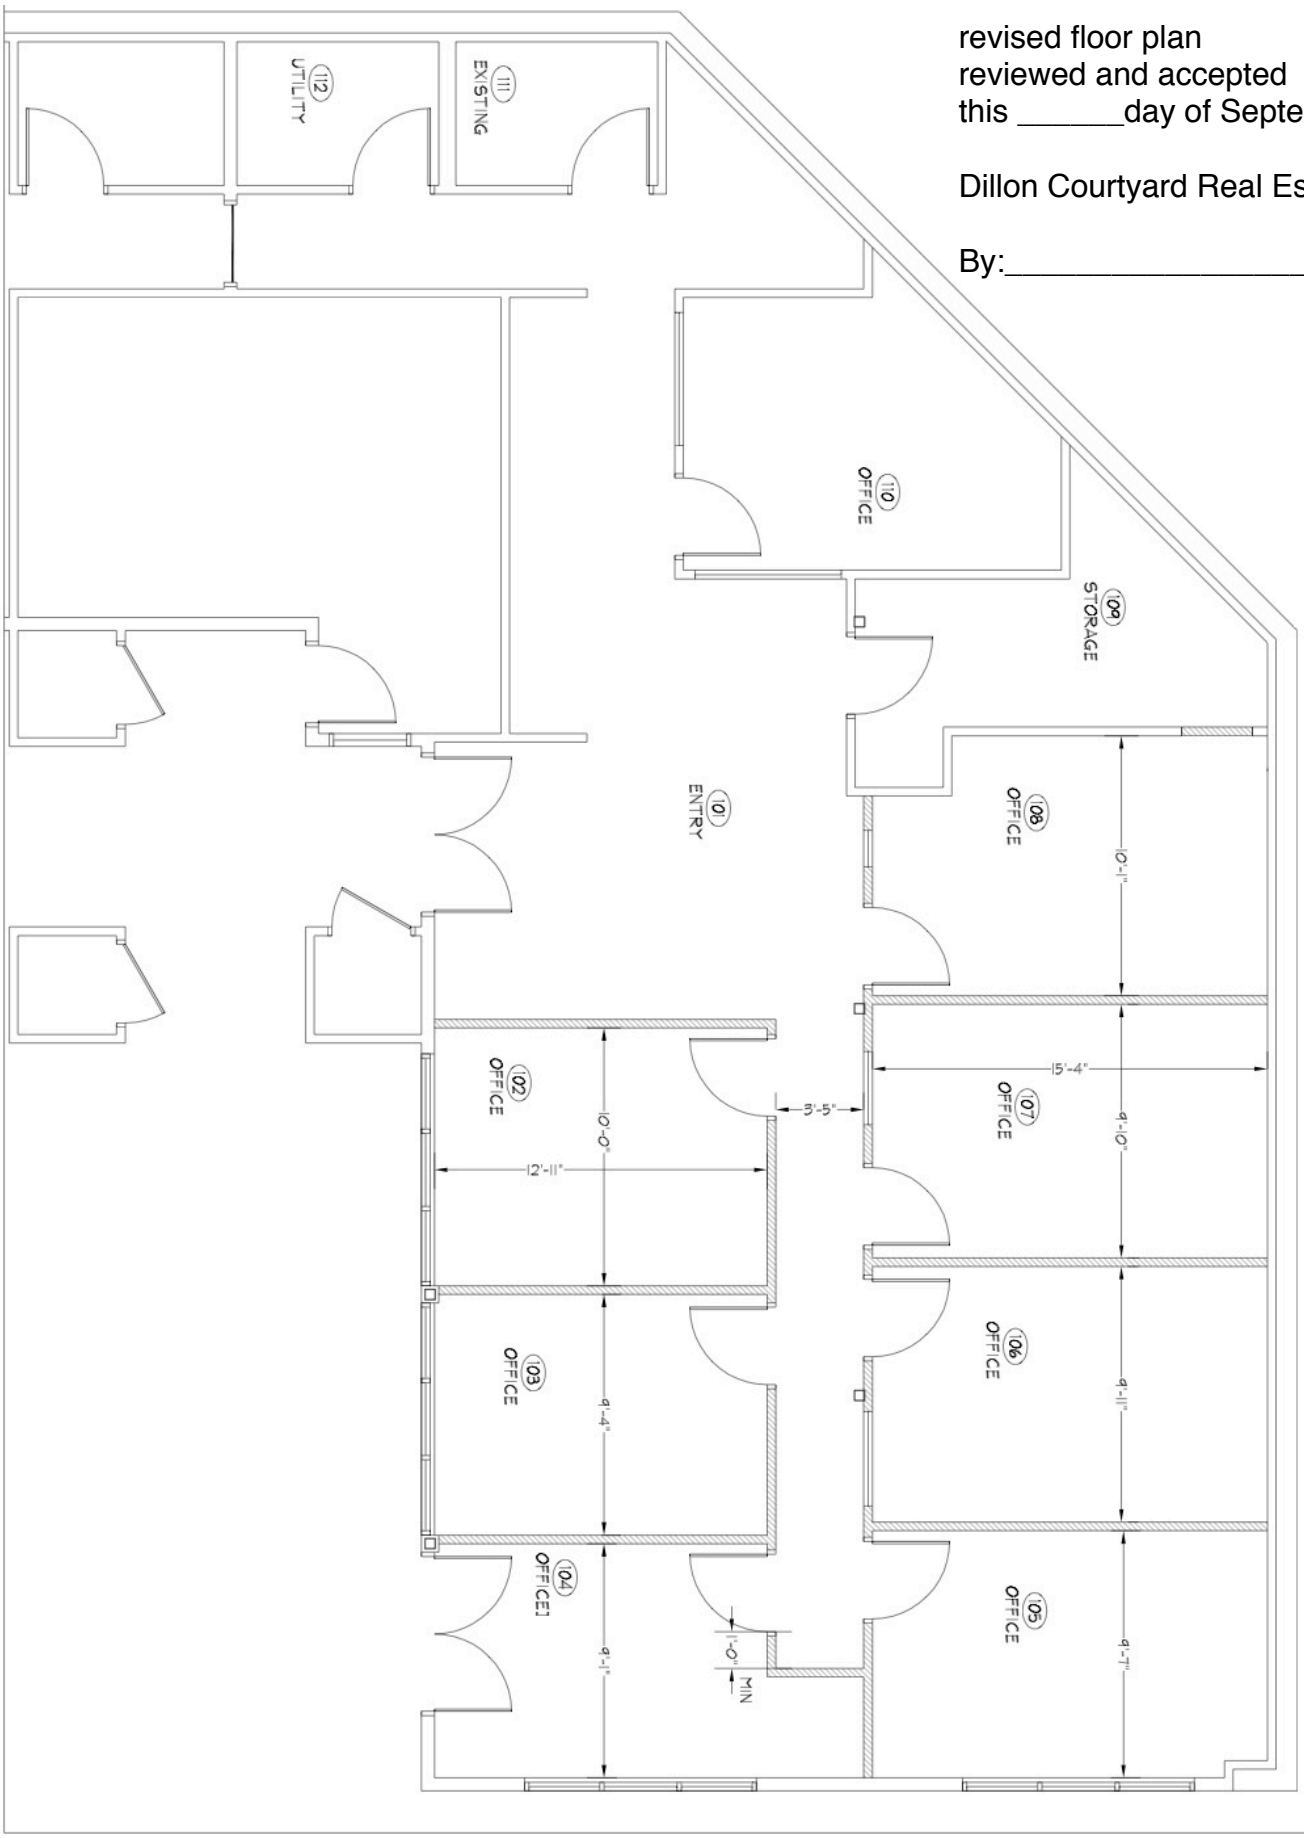

SCALE: PER PLAN
DATE: 03SEP10
PROJECT: 2010-A06

DILLON COURTYARD
707 ANEMONE TRAIL, DILLON, CO

C. PELL, ARCHITECT, LLC
cpell_arch@yahoo.com
6354 S. BLACKHAWK WAY, 303-718-1343