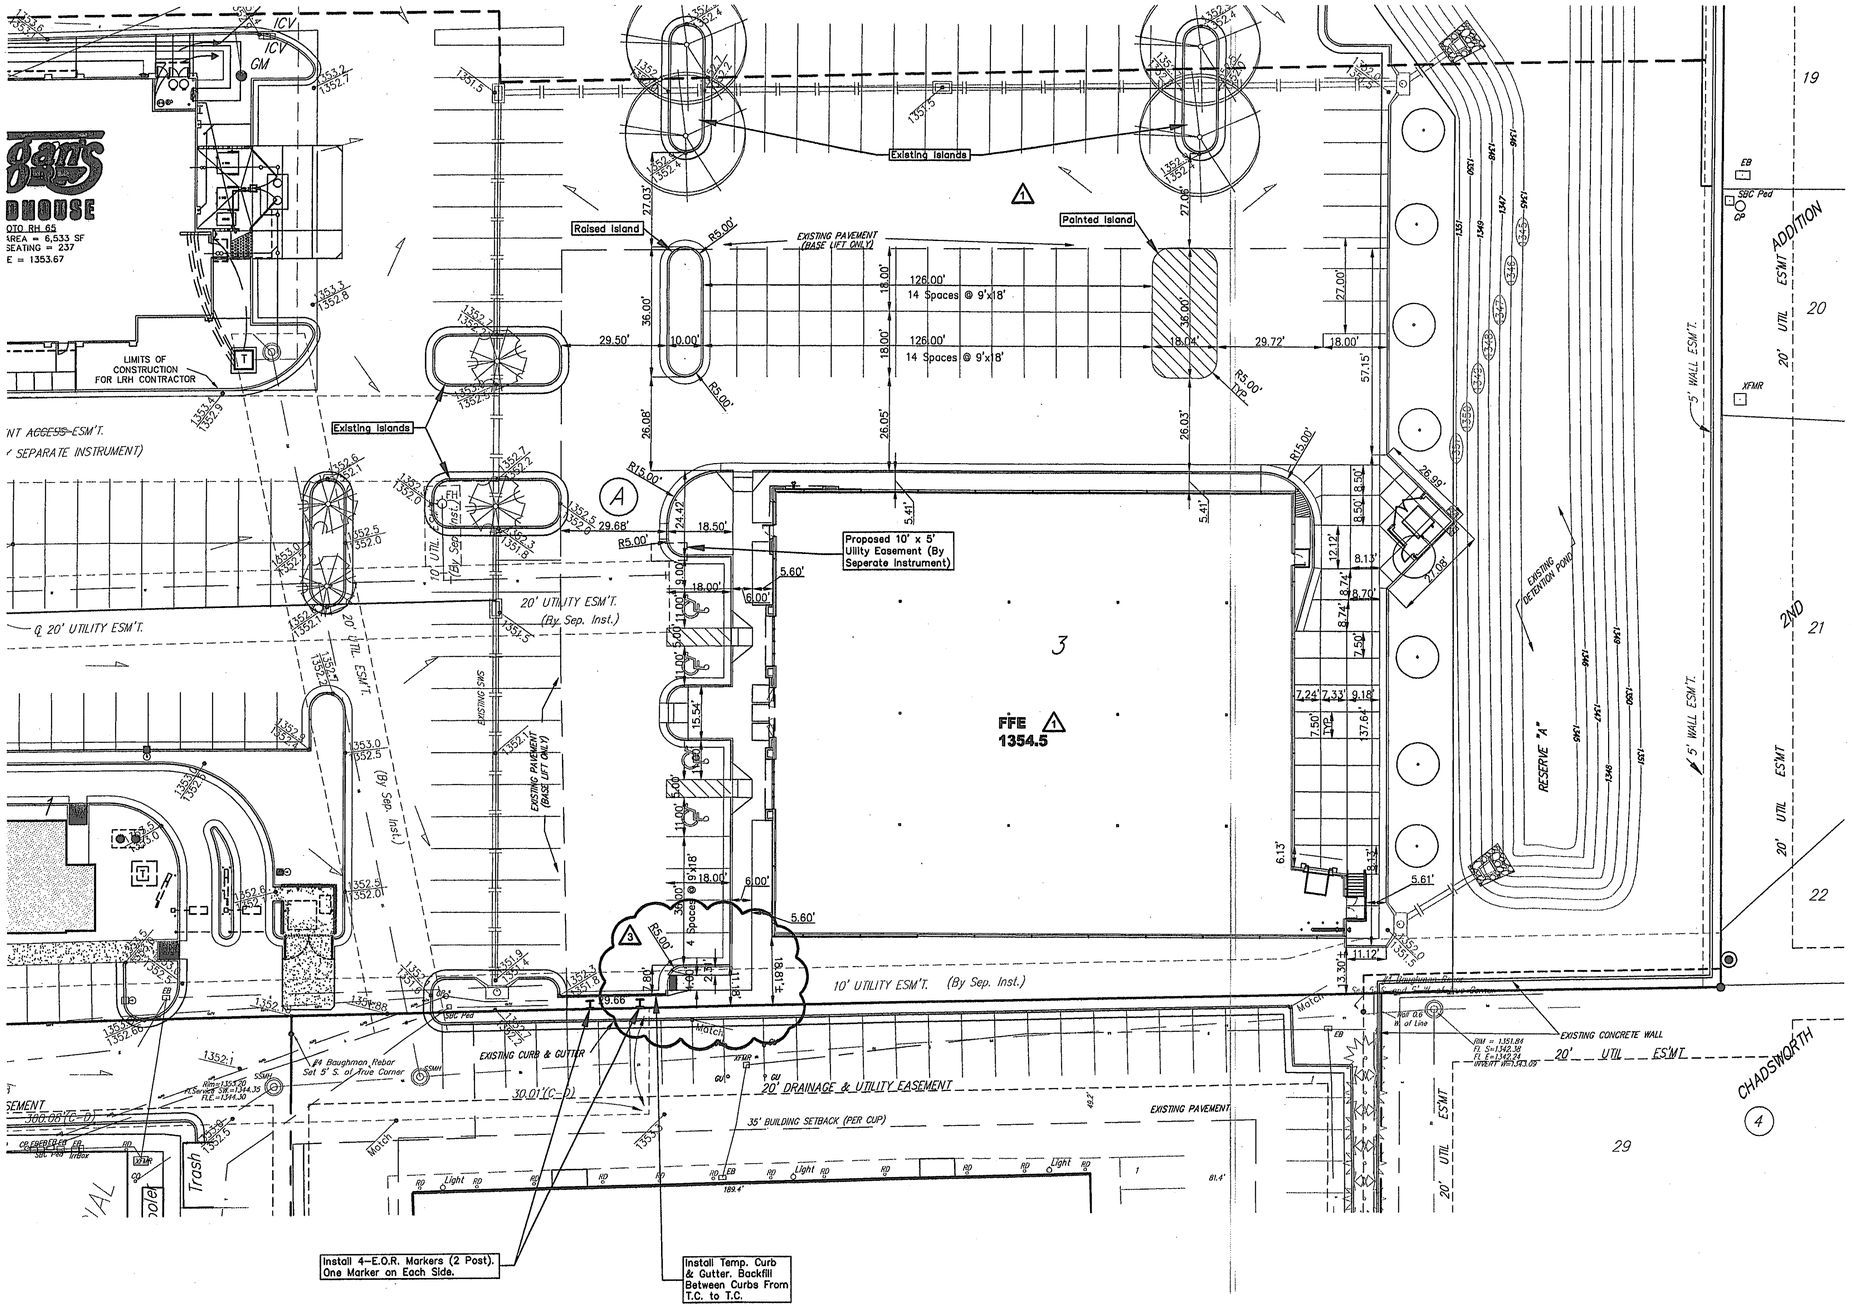

LAYOUT NOTES

1. Contractor shall be required to provide notice to Kansas One Call at 687-2470 a minimum of two (2) working days prior to any excavation or work adjacent to utilities.
2. The Contractor must notify the following in case of an emergency:

   Kansas Gas Service (Gas).....1-888-482-4950
   Aquila Energy (Gas).....1-800-303-0357
   Westar Energy (Electric).....383-8650
   Cox Communications (Cablevision).....262-4270
   AT&T (Phone).....268-2759
   City of Wichita Water Dept. (Water).....268-4563
   or 268-4908
   City of Wichita Sewer Maint.(San. Sewer).....268-4024
   or 262-6000
   City of Wichita Storm Sewer Maint. (Storm Sewer).....268-4090
   City of Wich Traffic Maint.(Traf. Control).....268-4034
   or 268-4203
   Conoco Pipeline Co. (Petroleum).....1-800-231-2551
   Williams Pipeline Co. (Petroleum).....529-6600
   or 1-800-324-9696
   Phillips Pipeline Co. (Petroleum).....1-800-765-8230

3. Existing utilities and their locations, as shown on the plans, represent the best information obtainable for design. Location information has been obtained from the various utility companies and is either from company record drawings or company provided field locations. The Contractor will be required to work around existing utilities which do not conflict with proposed construction.
4. Traffic affected by the construction on this project shall be handled in accordance with the latest edition of the Local Manual on Uniform Traffic Control Devices.
5. The Contractor shall verify all utility locations prior to construction of this project.
6. Signing and striping shall be installed in accordance with Local City Specifications and Codes. Striping shall be painted markings in conformance with the latest edition of the Standard Specifications for State Road and Bridge Construction by the Kansas Department of Transportation.
7. Dimensions shown are to face of curb or edge of pavement unless otherwise noted.
8. The Contractor shall notify adjacent landowners prior to proceeding with any construction work on landowner's property.

1" = 20'

3 REVISION 3 – 11 May 2007
2 REVISION 2 – 24 Apr 2007
1 REVISION 1 – 12 Mar 2007

MICHAEL WILLIAM STUMP
15629
05/11/2007
KANSAS
PROFESSIONAL ENGINEER

Baughman

E.S. DEVELOPMENT
LAYOUT PLAN
OFFICE MAX

Baughman Company, P.A. 315 Ellis St. Wichita, KS 67211 P 316.262.2221 F 316.262.0149
ENGINEERING | SURVEYING | PLANNING | LANDSCAPE ARCHITECTURE

PROJECT NUMBER	DESIGN MS	DRAWN DML
REVISIONS:	APPROVED MS	DATE 3.16.07
	SCALE AS SHOWN	
	SHEET 1 OF 4	

E:\eng\E.S. Development\base_NEW-OFFICE MAX.dwg 07-02-E760