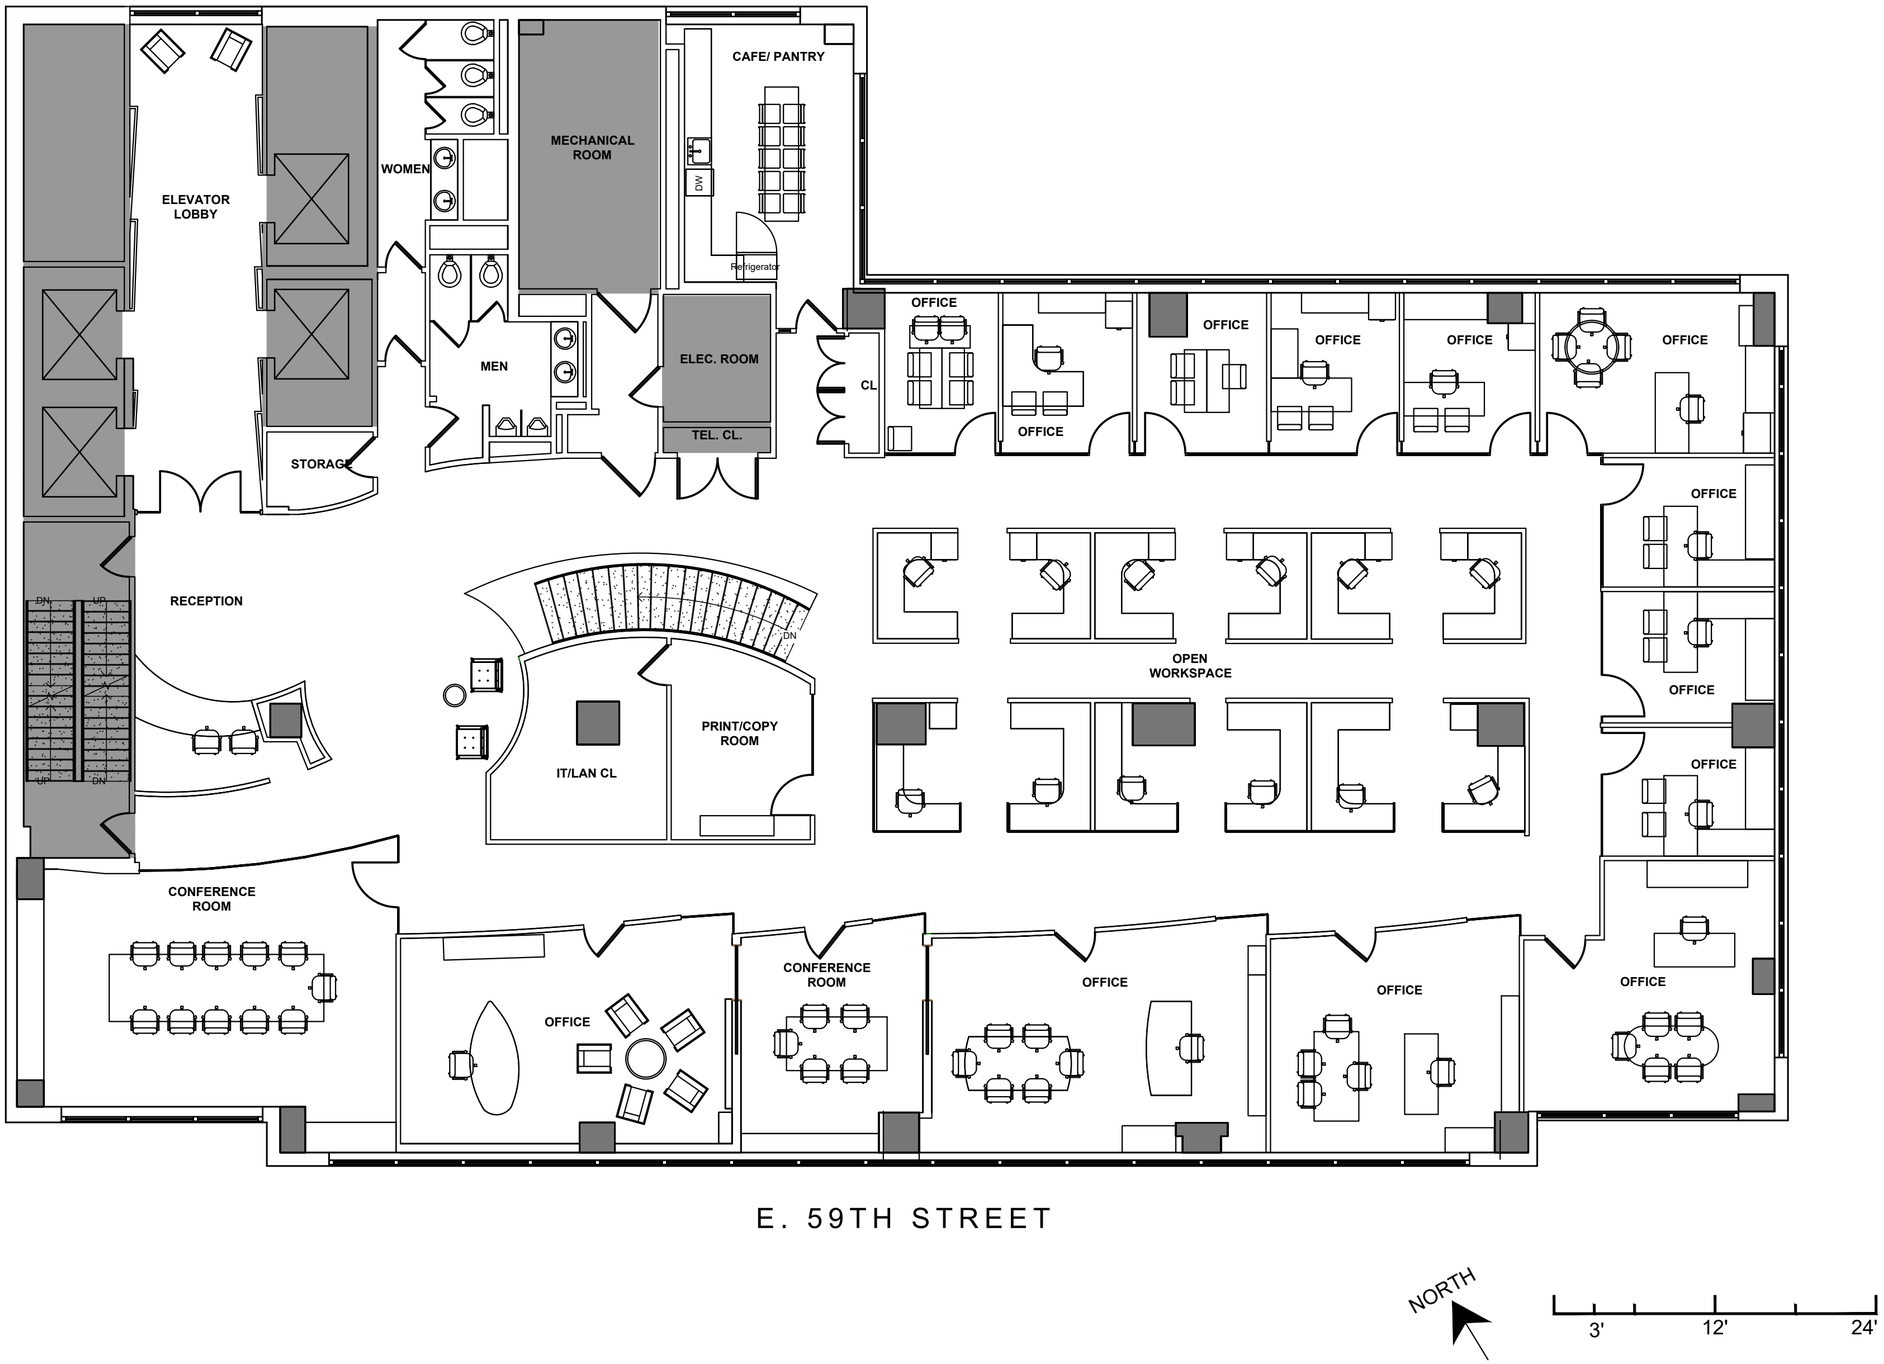

MKDA

55 E 59TH STREET

11TH FLOOR

AS-BUILT

04.03.25