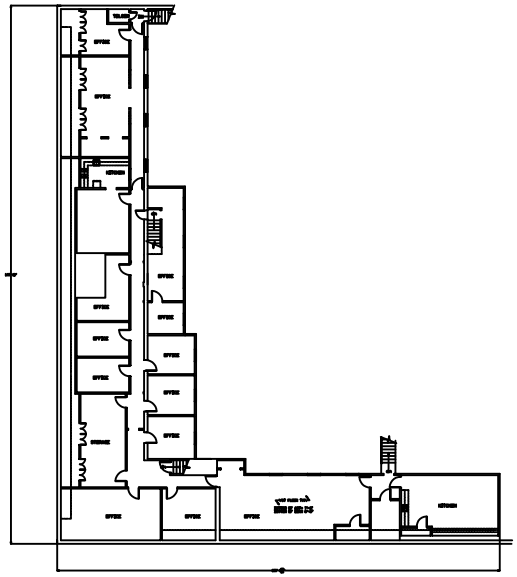

2 EXISTING SECOND FLOOR PLAN
SQUARE FT. = 6,692

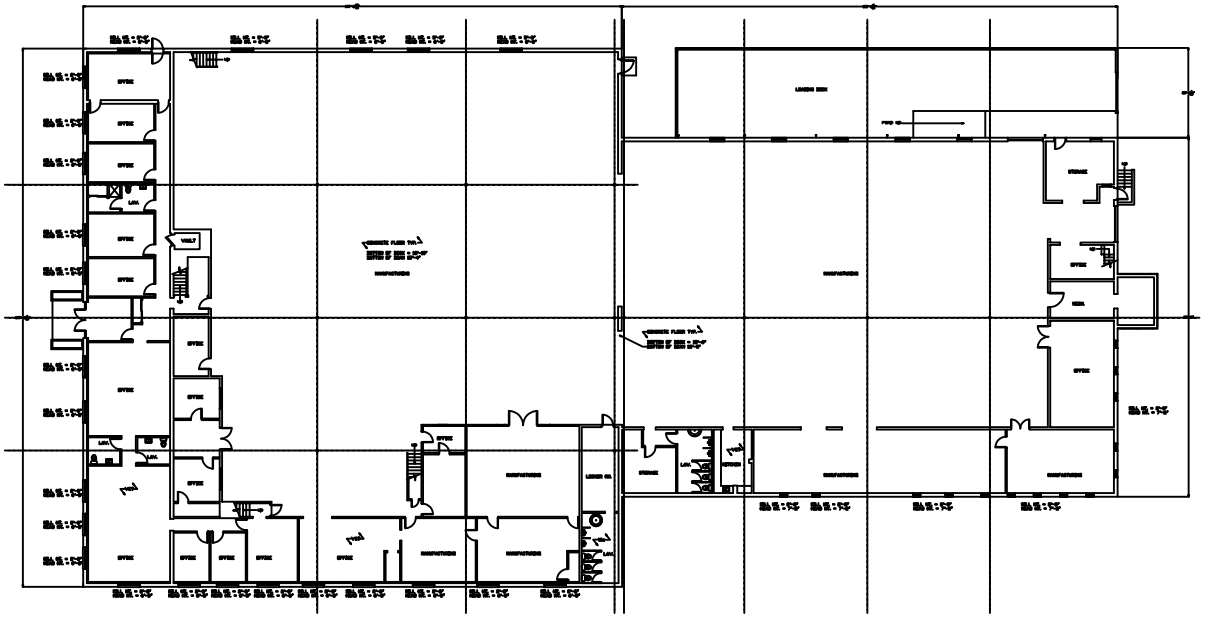

1 EXISTING FIRST FLOOR PLAN
SQUARE FT. = 39,493

206 South Main Street
Middleton, MA.

Existing Architectural
Floor Plans

Existing Conditions Surveys Inc.

398 Columbus Avenue #334
Boston, MA 02116 USA

T 617.247.9161
F 617.249.0746
E info@existingconditions.com

The Most Accurate
Existing Conditions Surveys and
As-Built Surveys

No.	Date	Revision	By

No.	Date	Issued to	By

Title
Existing floor Plans
Ground Floor / Mezzenine

Date	11.22.2006
Scale	1/16" = 1'-0"
Job No.	2534
Drawn By	kjr

EX-1