VETERANS CROSSING

6140 VETERANS PARKWAY GARNER, NC 27529

SUITE 150

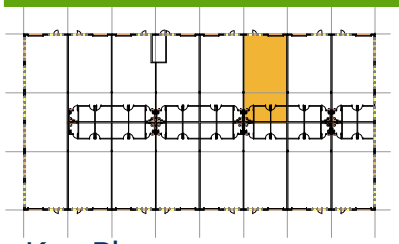

Key Plan

TOTAL SF AVAILABLE -1,811 RSF

OFFICE - 315 RSF

WAREHOUSE - 1,496 RSF

Click to access **CADD file**

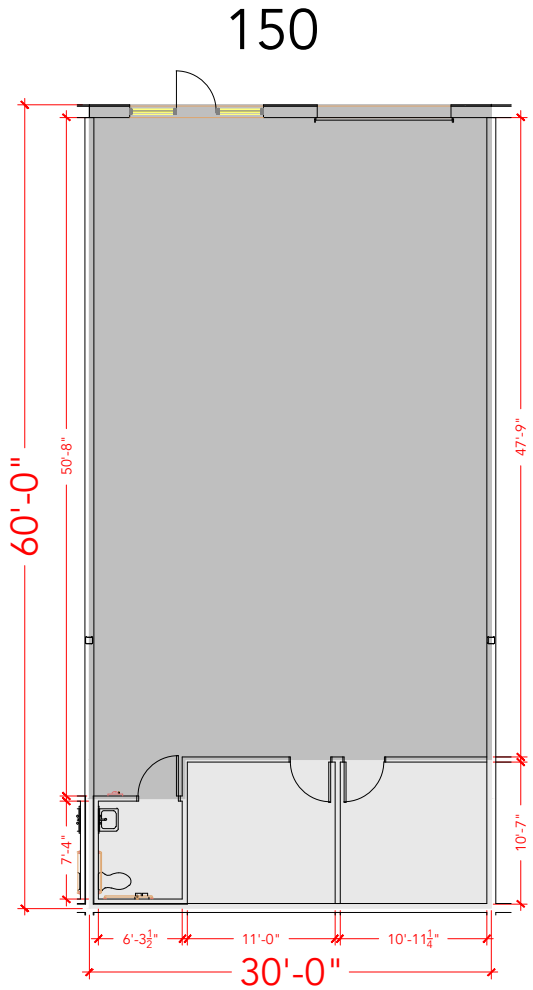

Floor Plan

PLAN NOT TO SCALE - THIS IS NOT A CONSTRUCTION DOCUMENT

DRAWING #: NCFT3-150 ASBUILT DATE:NEEDS TO BE