BUCKEYE
CONSTRUCTION & EXCAVATING
PO BOX 75 • ORIENT, OH 43146

AS-BUILT FORM (B)

CENTRAL OHIO AUTHORIZED DEALER
ENVIRO-GUARD - MULTI-FLO - NAYADIC - SYBRE AER
Residential & Commercial Sewage Treatment Systems

Site Drawing

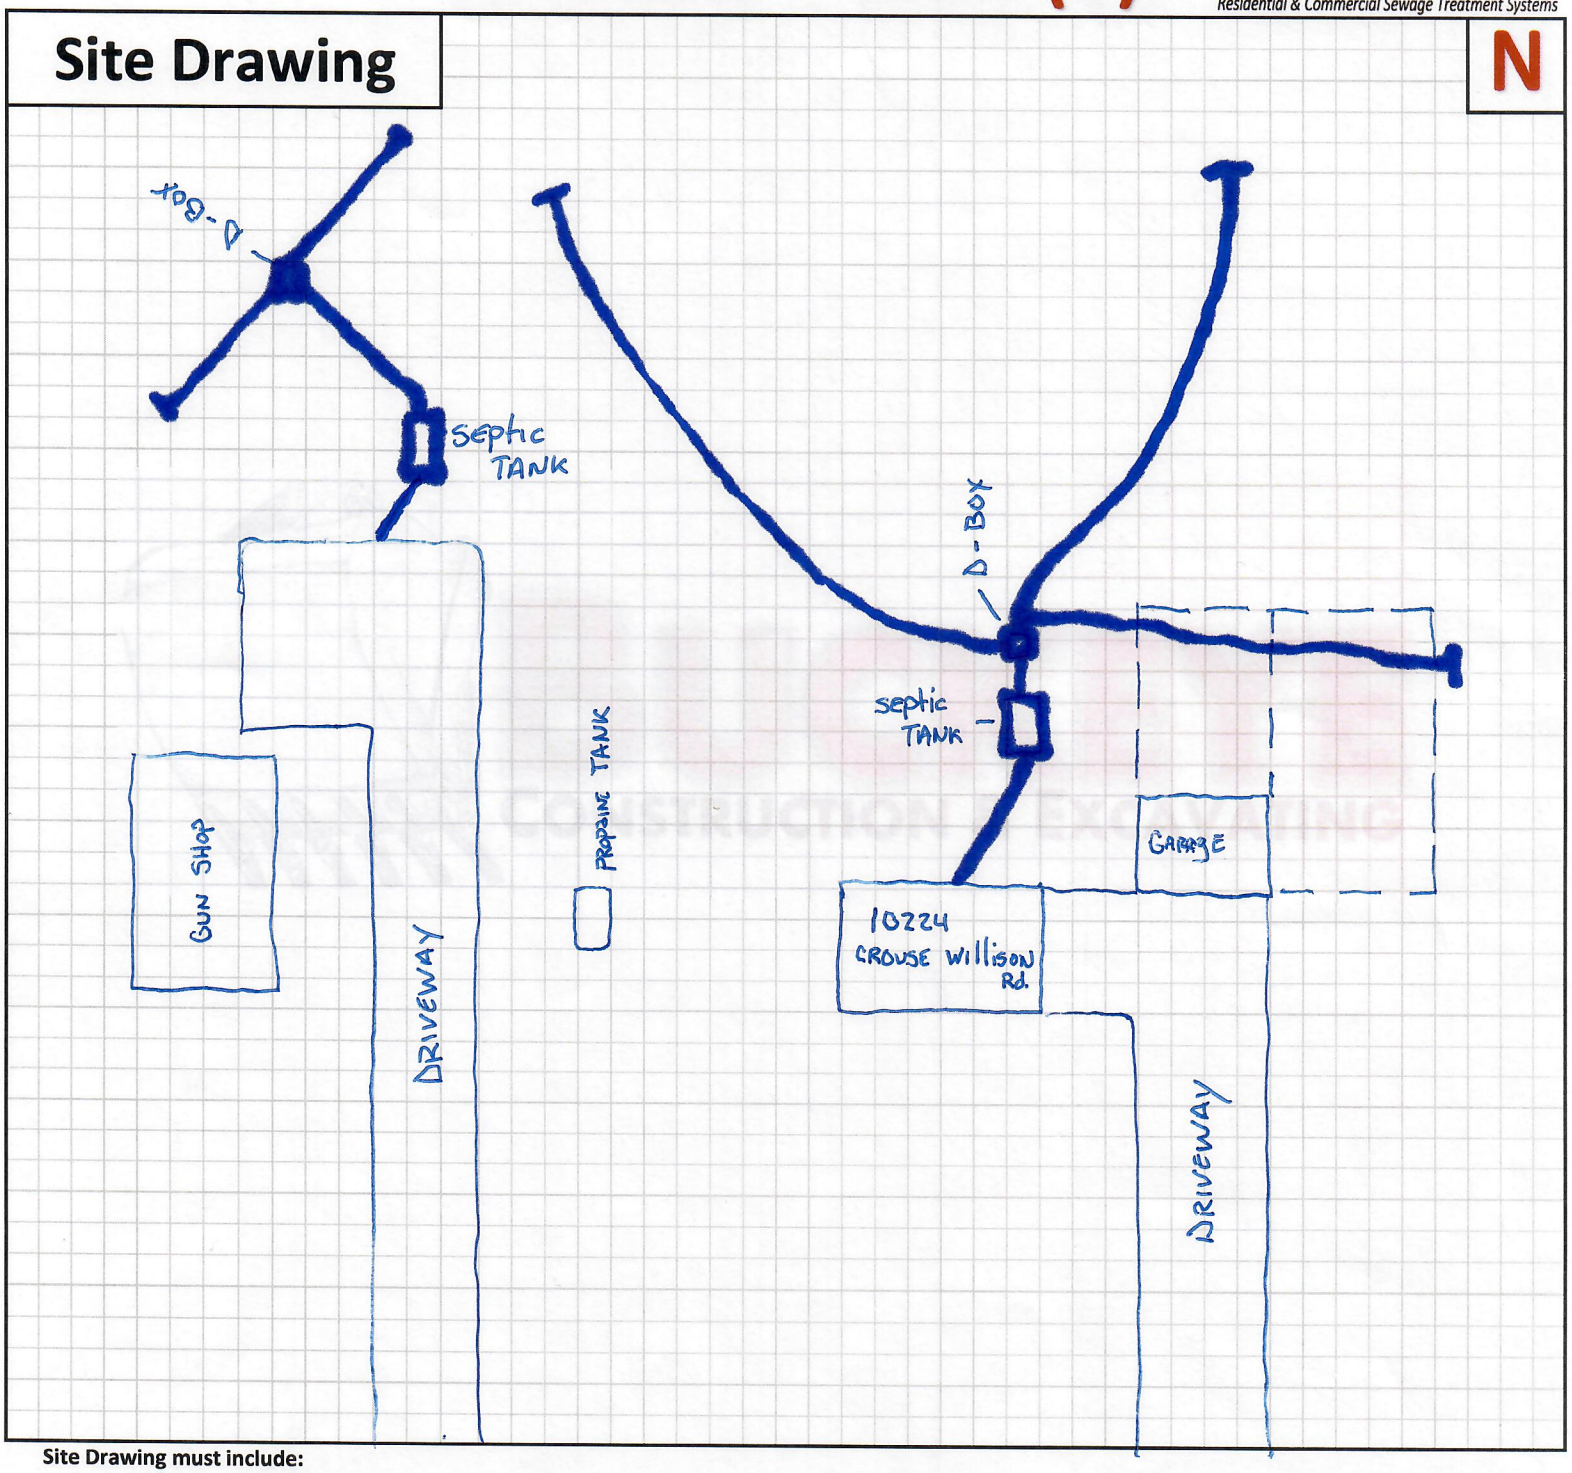

Site Drawing must include:

1. Tanks (i.e. Septic, Aeration, Dosing, Lift)
2. Layout of leaching, mound, drip irrigation, spray irrigation areas
3. Location of control panel and alarm
4. Secondary/Replacement area
5. Existing and/or proposed structures, driveways, hardscapes utility lines, swimming pools, ponds, etc…
6. Precise and detailed measurements
7. Benchmark location with elevation
8. Amount of fall (from house to tank, from tank to absorption area)
9. North arrow (Upper right-hand corner)

PROPERTY INFORMATION	
STREET ADDRESS	**CITY**
10224 CROUSE Johnstown OH 43031	Johnstown