HERE
DESIGNANDARCHITECTURE
C.F.H. SVOBODA-SPANBOCK, ARCHITECT
12029 STANWOOD DRIVE L.A. CA 90066
T: 310 880 3091 F: 310 915 9807
heredesign@verizon.net
www.heredesign.net

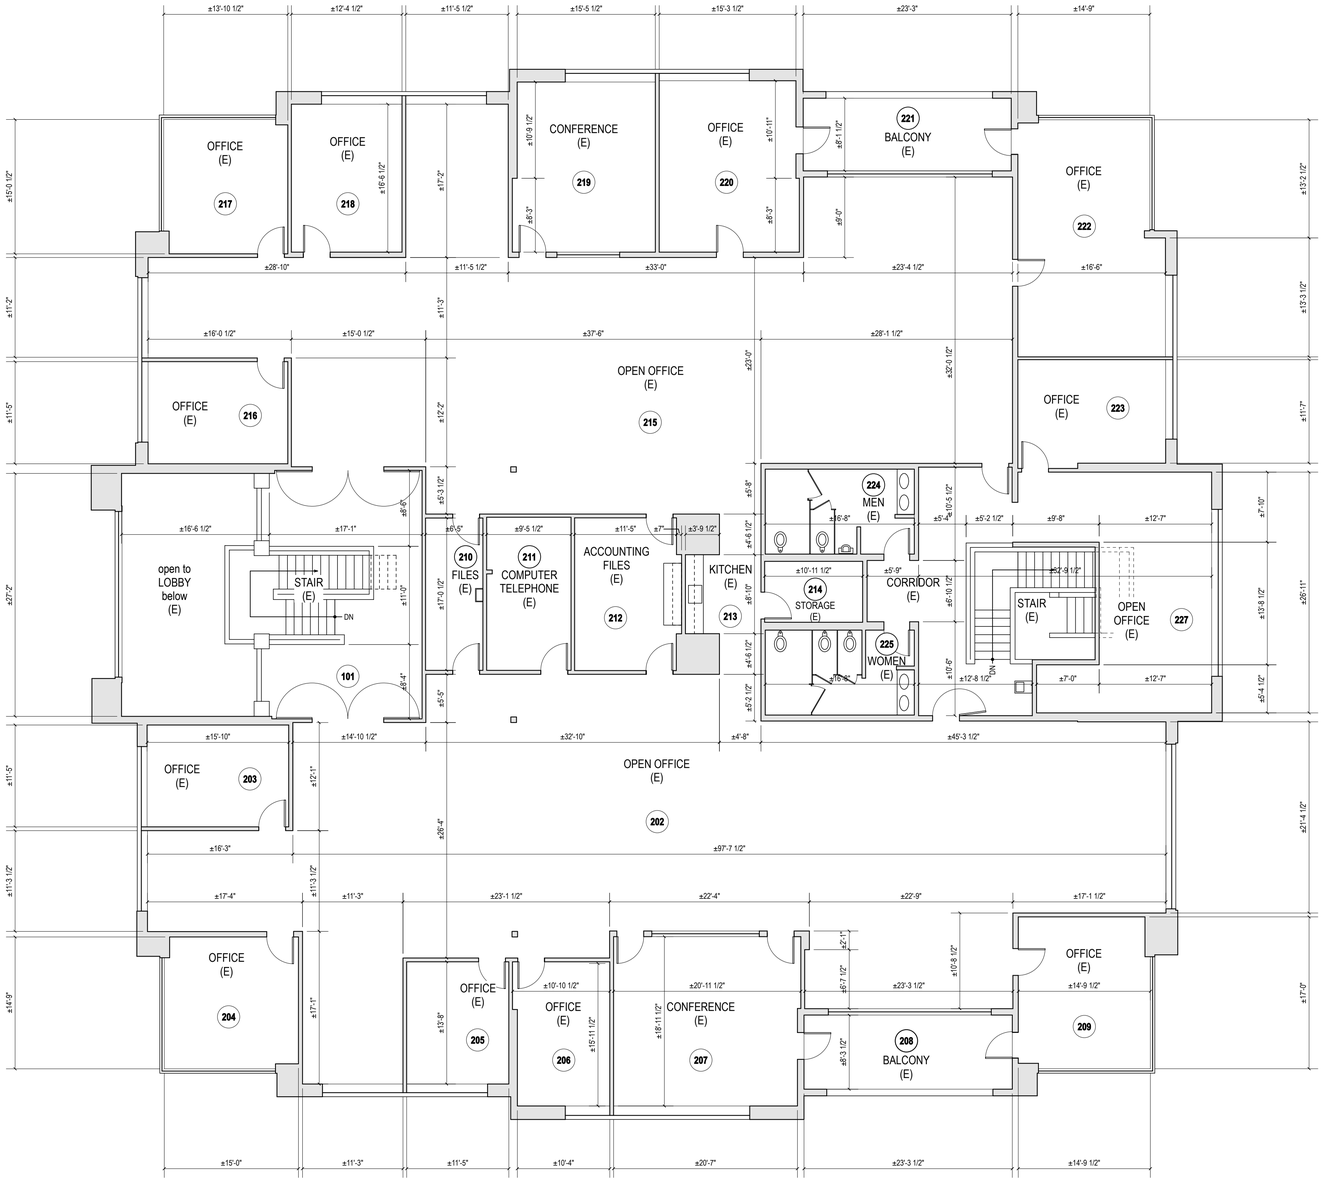

EXISTING SECOND FLOOR PLAN

PROJECT NORTH

8' 4' 2' 0 5' 10'

1/8" = 1'-0"

NOTES:

1. DIMENSIONS ARE TO FACE OF FINISH. ACCURACY OF DIMENSIONS IS SUFFICIENT FOR GENERAL PLANNING USE. ANY SPECIFIC DESIGN PROJECT SHALL REQUIRE FIELD VERIFICATION OF PERTINENT DIMENSIONS.

2. WALL CONSTRUCTION TYPES VARY AND MAY INCLUDE CAST CONCRETE, FRAMING, STEEL COLUMNS, OR A COMBINATION THEREOF. THICKNESSES VARY ACCORDINGLY.

EXISTING SECOND FLOOR PLAN

© 2012 C.F.H. Svoboda-Spanbock, Architect
All rights reserved. No part of this drawing may be reproduced except as in accordance with the Agreement between Architect and Owner, executed April 1, 2011. These drawings are intended for general planning use only. No warranty, expressed or implied, is conveyed as to their accuracy or sufficiency for any specific use. All relevant dimensions shall be verified in field prior to commencement of any specific design project.

Interior Drawings of Existing Facility:

417 BRYANT CIRCLE
OJAI, CA 93023

03.30.12

EX-2.2