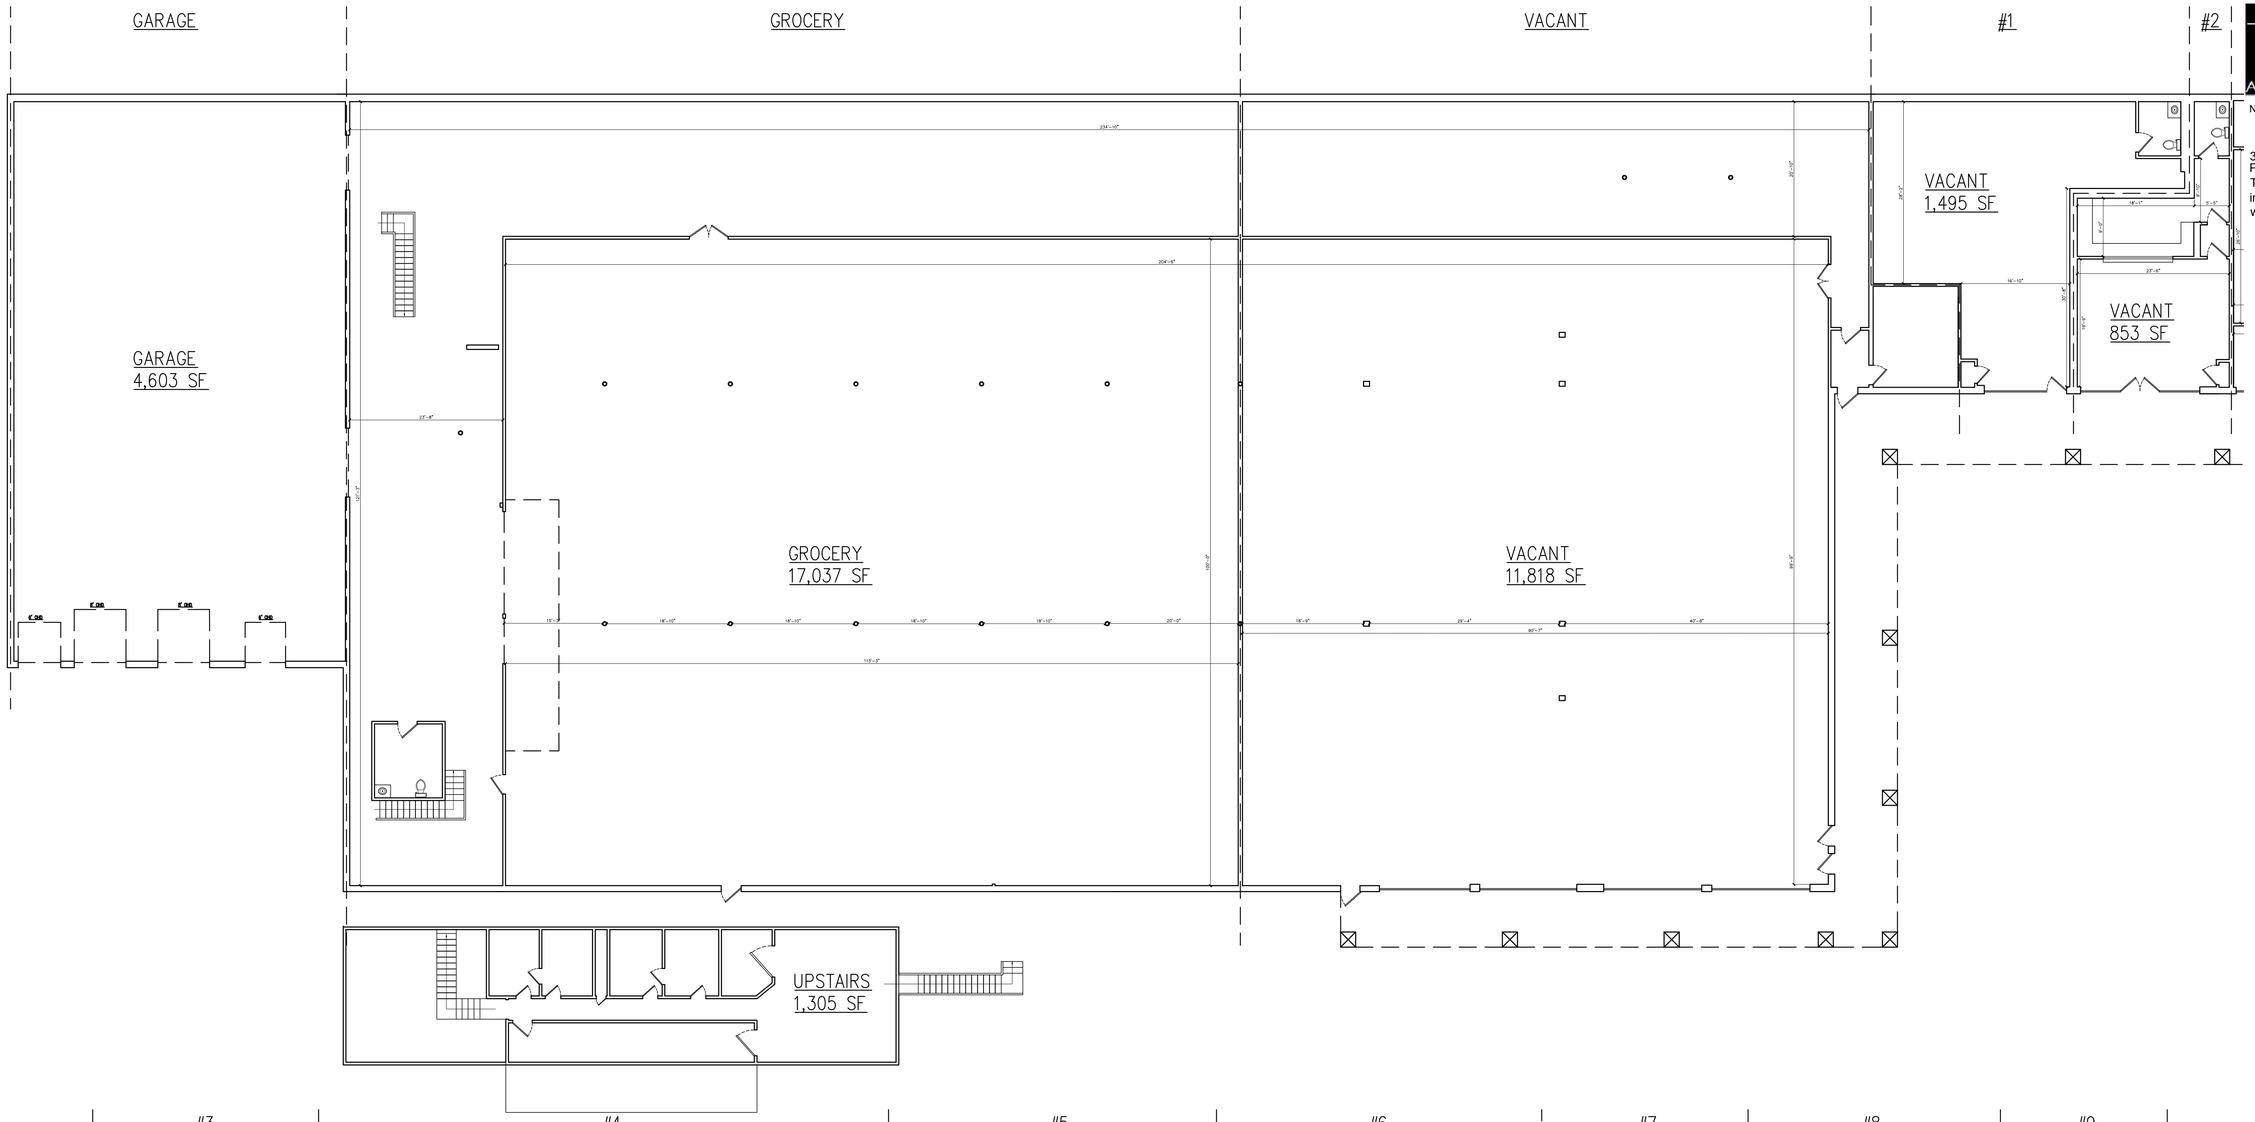

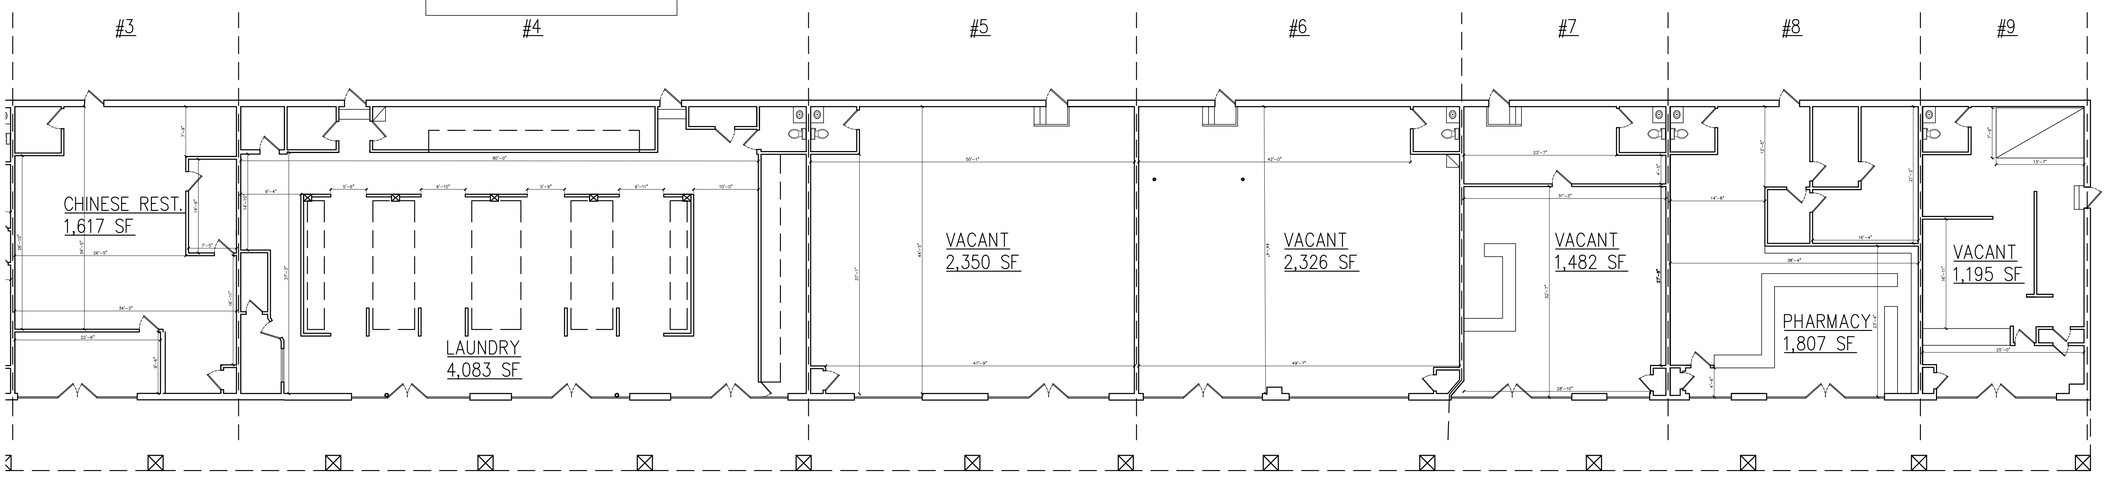

TEKTON
ARCHITECTURE STUDIO LLC
NJ State Certificate of Authorization: AC-1147

337 State Highway 36
Port Monmouth, NJ 07758
Tel: 732.226.7135
info@tektonarchstudio.com
www.tektonarchstudio.com

LOCATION:
50 Stemler Dr.
Cliffwood, NJ.

AS BUILT RECORD DRAWING

Of the existing Commercial Spaces

Prepared for: ETC MANAGEMENT LLC

Document Date:
September 22, 2021

Document Phase:
Existing Documentation

PLANS

A 1.0