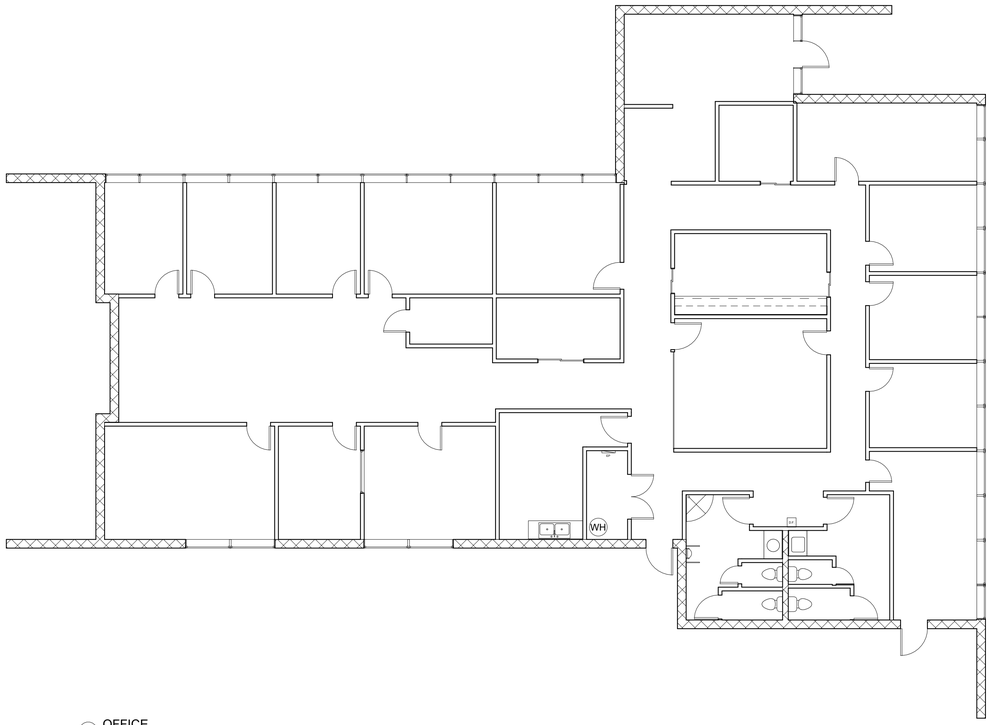

1 OFFICE
1/8" = 1'-0"

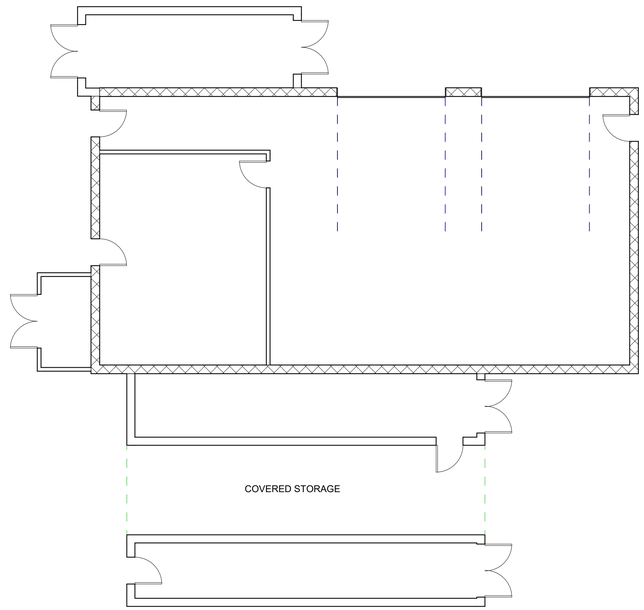

2 WAREHOUSE
1/8" = 1'-0"

N

Jones Commercial Interiors
3900 Willow Street, Suite 150
Dallas, TX 75226
Tele 972.690.3400
www.ajci.com

RAM CAPITAL
3300 ROCK ISLAND RD
IRVING, TEXAS 75060

No.	Description	Date

RAM CAPITAL

3300 ROCK ISLAND RD

AS BUILT

Project Number	PP00.1101
Date	10-18-24
Drawn By	AJ/BK/MEL
Scale	1/8" = 1'-0"
Sheet Size	24"X36"